

Appl. 26155

TELEPHONE TOWER 0640


PLAT OF SURVEY

OF PROPERTY OF R. L. Lotten Associates
DESCRIBED AS FOLLOWS Lot 6 Block 16 Boulevard Addition
N^o 1376 Laurel Ave, St. Paul, Minn.

SCALE: 1 INCH = 30 FEET

LAUREL AVE.

T. J. WELCH, REGISTERED SURVEYOR
738 SURREY AVENUE, ST. PAUL 6, MINN.

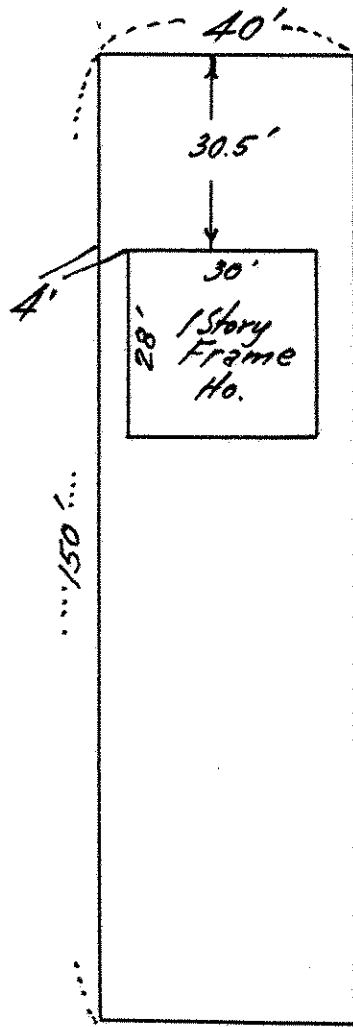

CERTIFICATE OF SURVEY

I hereby certify that on 10-19 1957
I surveyed the property described above and that the above
plat is a correct representation of said survey.

T. J. Welch