FROM THE OFFICE OF

Certificate of Survey

CHARLES O. GEORGI COMPANY

2215 West County Road B

Saint Paul 13, Minnesota

REGISTERED CIVIL ENGINEER AND LAND SURVEYOR

I Hereby Certify that this plat shows a survey made by me of the property described on this plat, and that the corners are correctly placed as shown, and that all locations have been correctly shown.

Surveyed For B. GORKA


Date July 1958

Scale /"=/00'

Description:

All of Lot I, Block 2, Lake Emily Addition No. 2 except
that part lying Northerly of a line distant 118.52 feet Southerly at
right angles and parallel to the North line of said Lot I; subject
to an easement for road purposes over the Westerly 20 feet thereof.

E subject to utility Easement.

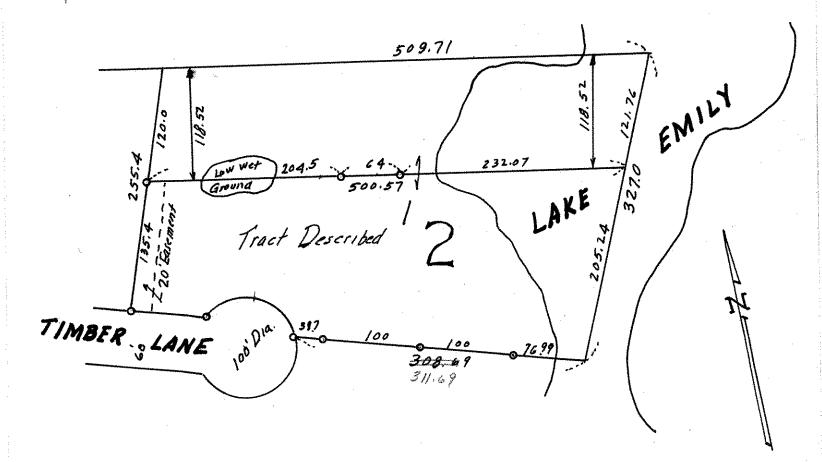

· Denotes Iron Monument.