

FROM THE OFFICE OF

# CHARLES O. GEORGI COMPANY

2215 West County Road B

Saint Paul 13, Minnesota

REGISTERED CIVIL ENGINEER AND LAND SURVEYOR

## Certificate of Survey

I Hereby Certify that this plat shows a survey made by me of the property described on this plat, and that the corners are correctly placed as shown, and that all locations have been correctly shown.

Surveyed For Assoc. *CONTRAS - W. Nordberg.*

Date *November 1958*


Scale *1" = 50'*

By

*Charles O. Georgi*  
REGISTERED LAND SURVEYOR

Description:

*Lot 11 and the East 1/2 of Lot 10  
Block 2  
LINDEMANN'S SUBDIVISION (OF HYDE PARK)*

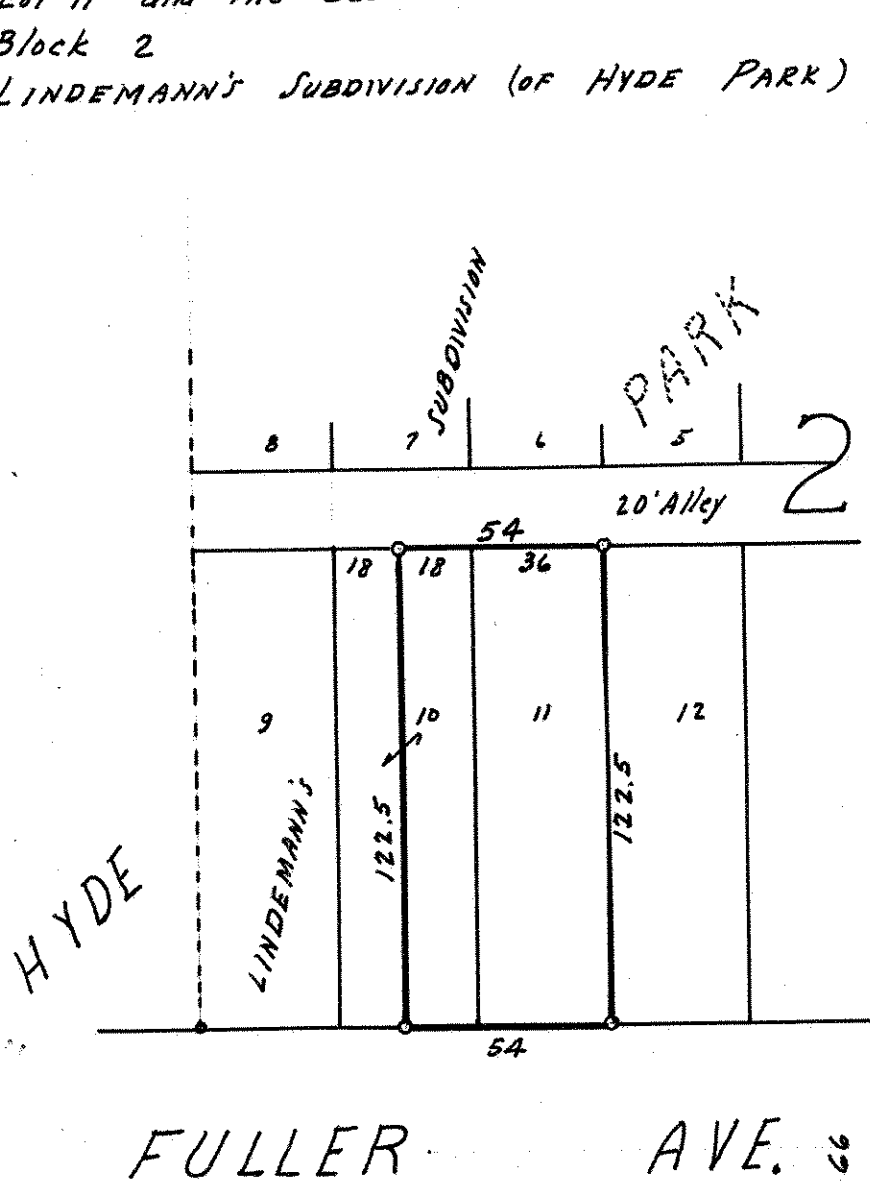

o Denotes Iron Monument