NW 17 29 22

FROM THE OFFICE OF

CHARLES O. GEORGI COMPANY

2215 West County Road B Saint Paul 13, Minnesota

REGISTERED CIVIL ENGINEER AND LAND SURVEYOR

Certificate of Survey

I Hereby Certify that this plat shows a survey made by me of the property described on this plat, and that the corners are correctly placed as shown, and that all locations have been correctly shown.

Surveyed For MR. & MRS. GEORGE A. GENNOW

Date October 1958

Scale 1" = 100'

By Charles O. Georgi
REGISTERED LAND SURVEYOR

Description:

The East 90 feet of the West 513.0 feet of the North ½ of the NW¼ of the NE¼ of the NW¼ Section 17, T29N, R22W, subject to County Road B.

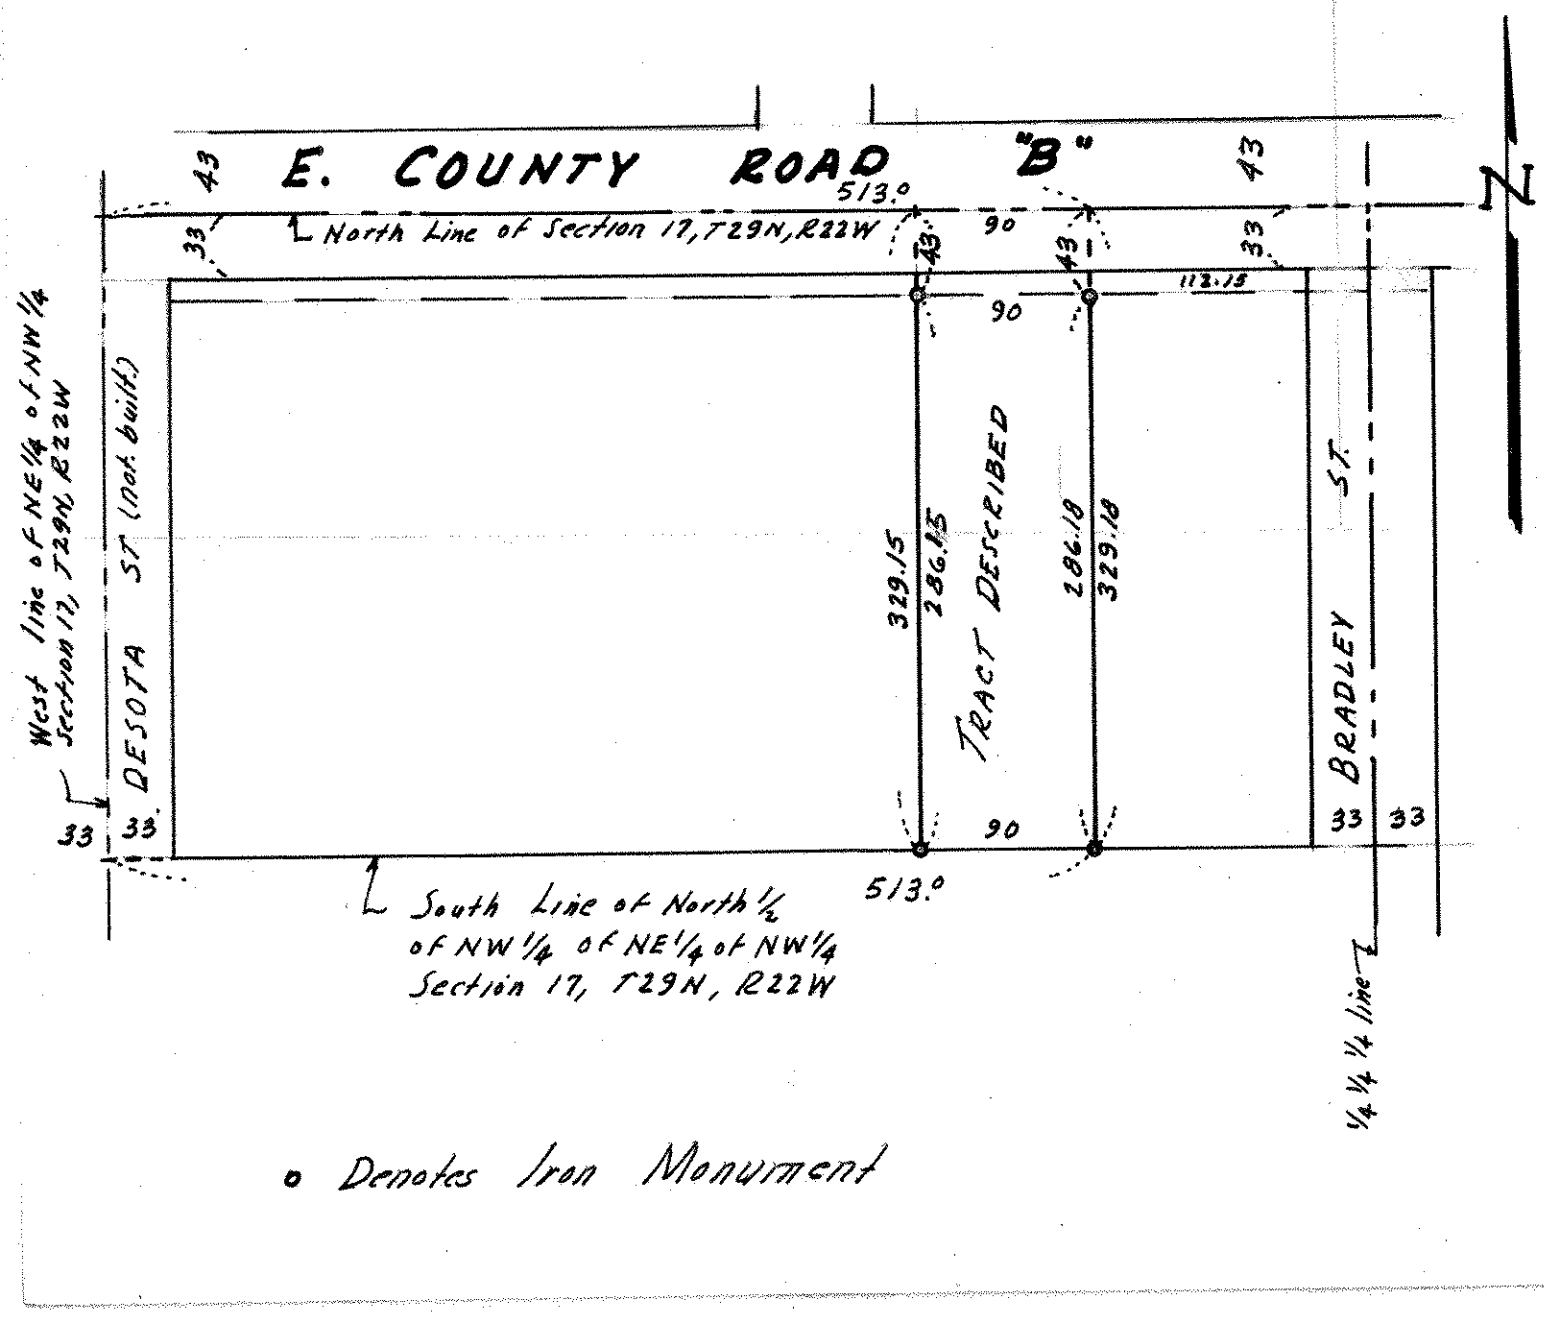

o Denotes Iron Monument