SW 34 2922?

FROM THE OFFICE OF

CHARLES O. GEORGI COMPANY

2215 West County Road B — Saint Paul 8, Minnesota

REGISTERED CIVIL ENGINEER AND LAND SURVEYOR

Certificate of Survey

Linder

I Hereby Certify that this plat shows a ~~building location~~ Drawing survey made by me on the property described on this plat, and that all locations, have been correctly shown.

Date May 1958

Scale 1" = 100'

By Charles O. Georgi
REGISTERED LAND SURVEYOR

Description:
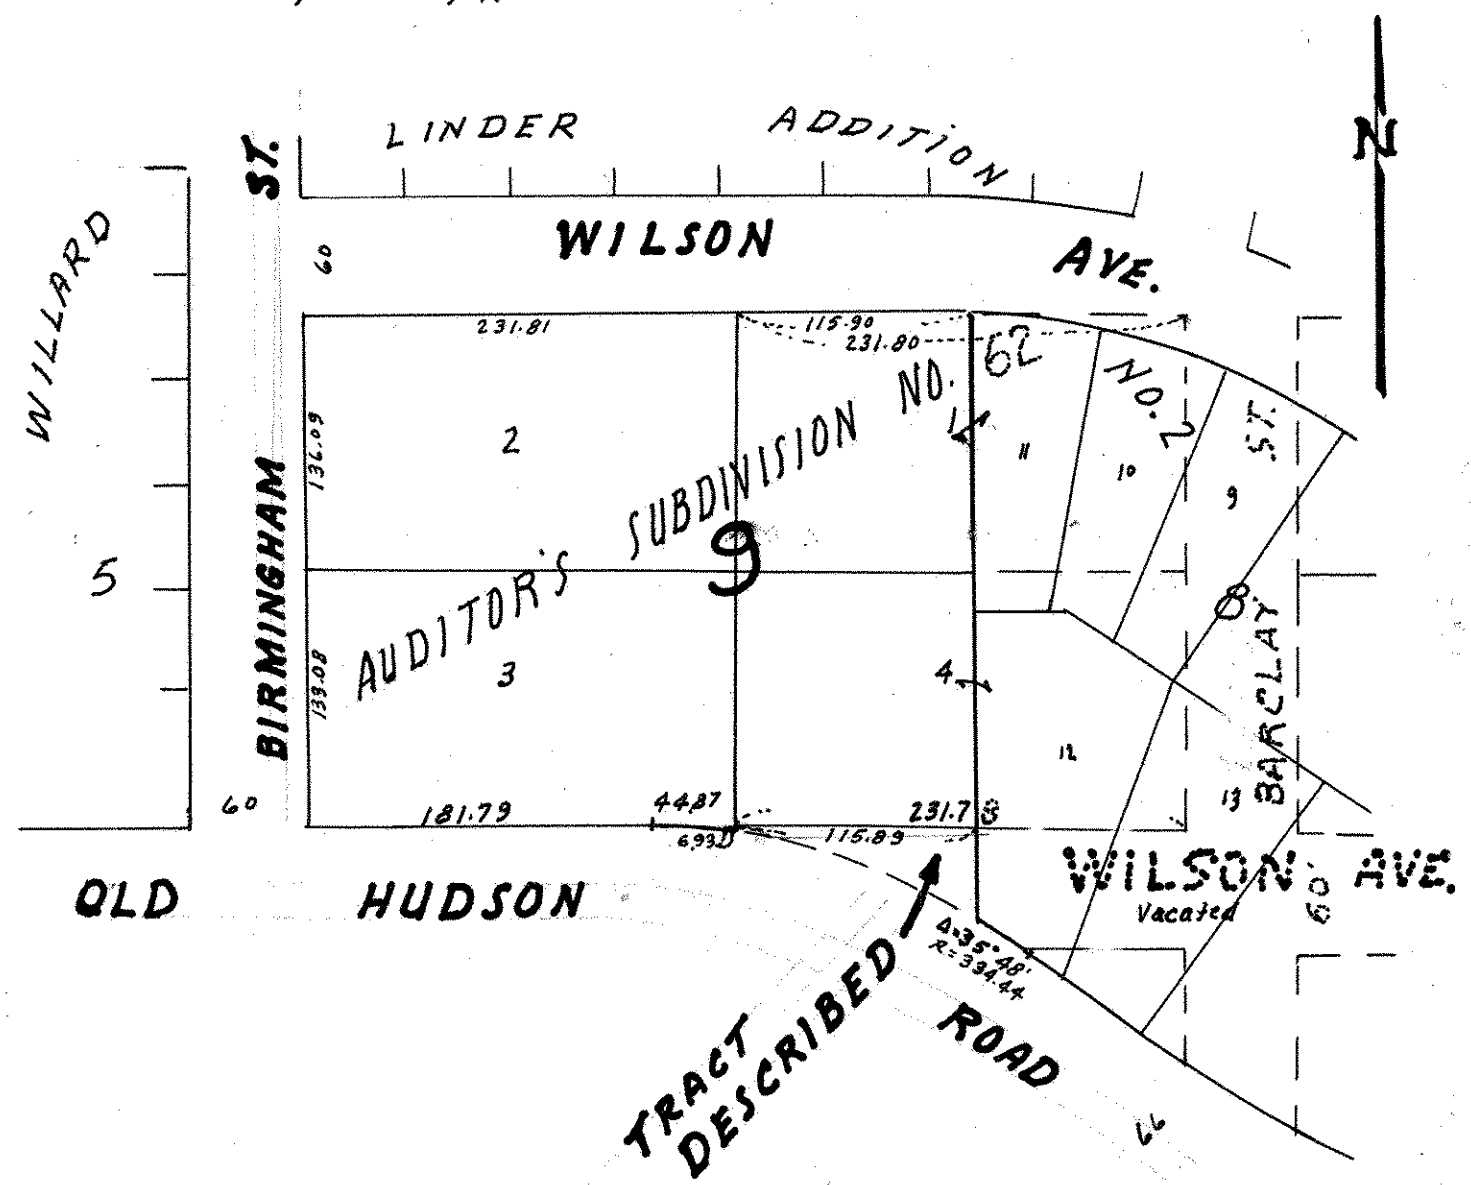
That portion of Wilson Ave. lying Westerly of the West line of the East 1/2 of Lots 1 and 4, Block 9, Auditor's Subdivision No. 62 produced South, lying Northerly of the North line of Old Hudson Road, and lying Southerly of the West 1/2 of said Lots 1 and 4, Block 9, Auditor's Subdivision No. 62