SE 34 30 23

FROM THE OFFICE OF

CHARLES O. GEORGI COMPANY

2215 West County Road B — Saint Paul 13, Minnesota

REGISTERED CIVIL ENGINEER AND LAND SURVEYOR

Certificate of Survey

I Hereby Certify that this plat shows a survey made by me of the property described on this plat, and that the corners are correctly placed as shown, and that all locations have been correctly shown.

Surveyed For MRS. BOHLAND

Date September 1959

Scale 1" = 100'

By Charles O. Georgi
REGISTERED LAND SURVEYOR

Description:

The South 93.9 feet of the North 157.3 feet of Government Lot 7, Section 34, T 30 N, R 23 W except the East 906.69 feet thereof, subject to use in common over the East 10 feet thereof; also use in common with others over the East 10 feet of the North 264.3 feet of said Government Lot 7 except the East 906.69 feet thereof; also use in common with others the cartway described in 590 Deeds 257.

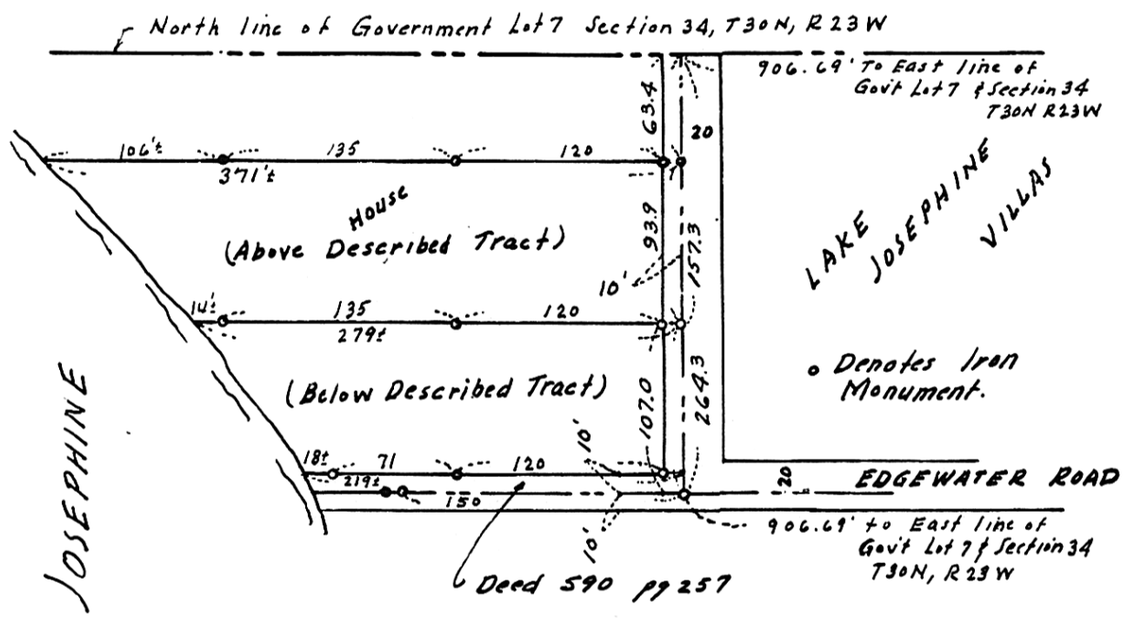

Description:

The South 107.0 feet of the North 264.3 feet of Government Lot 7 Section 34, T30N, R23W except the East 906.69 feet thereof, subject to use in common with others over the East 10 feet thereof, and subject to use in common with others the cartway described in 590 deeds 257; also use in common with others over the East 10 feet of the North 264.3 feet of said Government Lot 7 except the East 906.69 feet thereof.