SW 33 3023

FROM THE OFFICE OF

# CHARLES O. GEORGI COMPANY

2215 West County Road B — Saint Paul 13, Minnesota

REGISTERED CIVIL ENGINEER AND LAND SURVEYOR

## Certificate of Survey

*I Hereby Certify that* this plat shows a survey made by me of the property described on this plat, and that the corners are correctly placed as shown, and that all locations have been correctly shown.

*Surveyed For* Mrs. C. R. Pratt

*Date* April 1959

*Scale* 1" = 100'

By Charles O. Georgi
REGISTERED LAND SURVEYOR

*Description:* The West 75 feet of the East 150 feet of the W 424.5 feet of the South 189.66+ feet of the SW 1/4 of the SW 1/4 of Section 33, T30N, R23W

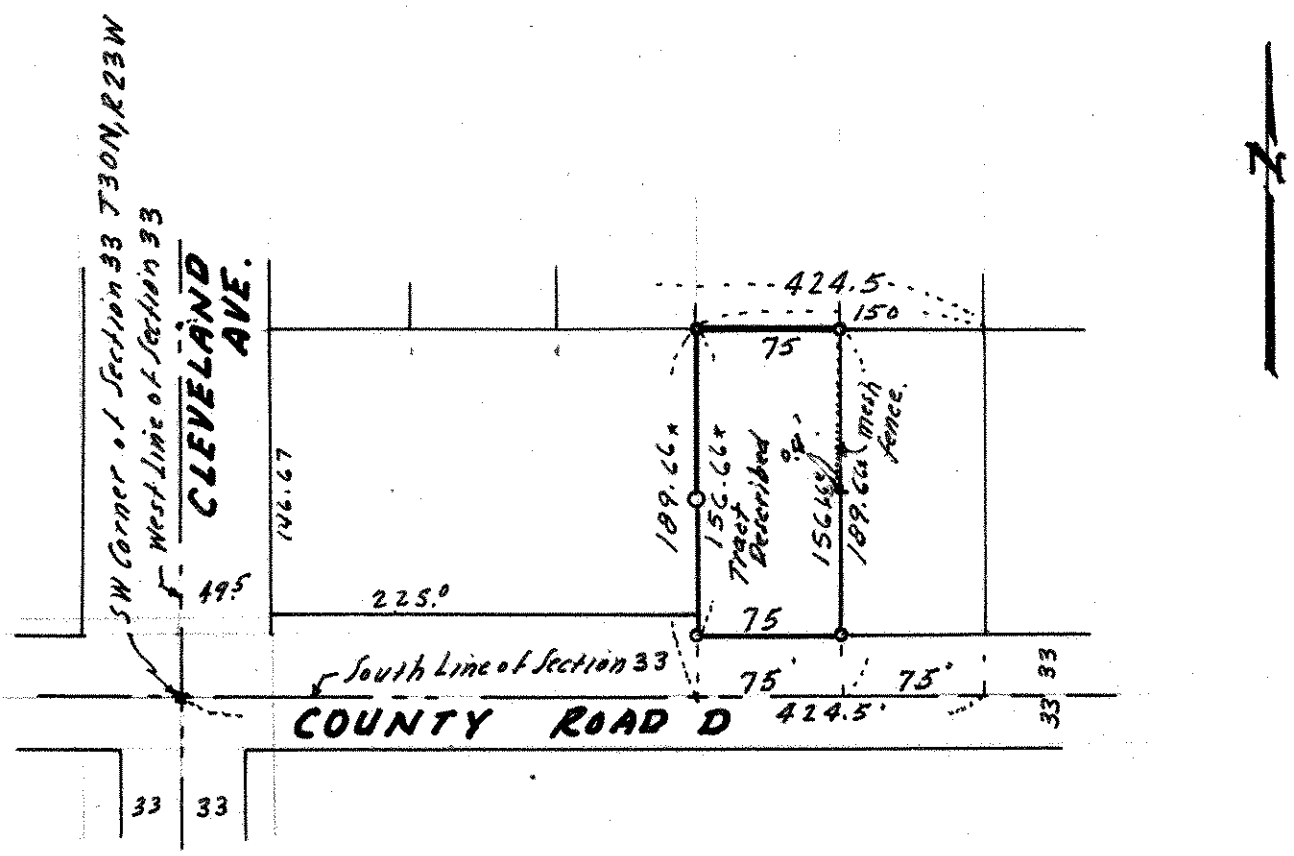


• Denotes Iron Monument

* Distance 189.66' & others shown as 189.67' etc. on plat DALSOREN ADDITION which indicated 0.01' difference.