FROM THE OFFICE OF

# CHARLES O. GEORGI COMPANY

2215 West County Road B — Saint Paul 8, Minnesota

REGISTERED CIVIL ENGINEER AND LAND SURVEYOR

# Certificate of Survey

For: H. HAGE

*I Hereby Certify that* this plat shows a building location survey made by me on the property described on this plat, and that all locations, have been correctly shown.

*Date* February 1959

*Scale* 1" = 100'

By Charles O. Georgi
REGISTERED LAND SURVEYOR

*Description:*
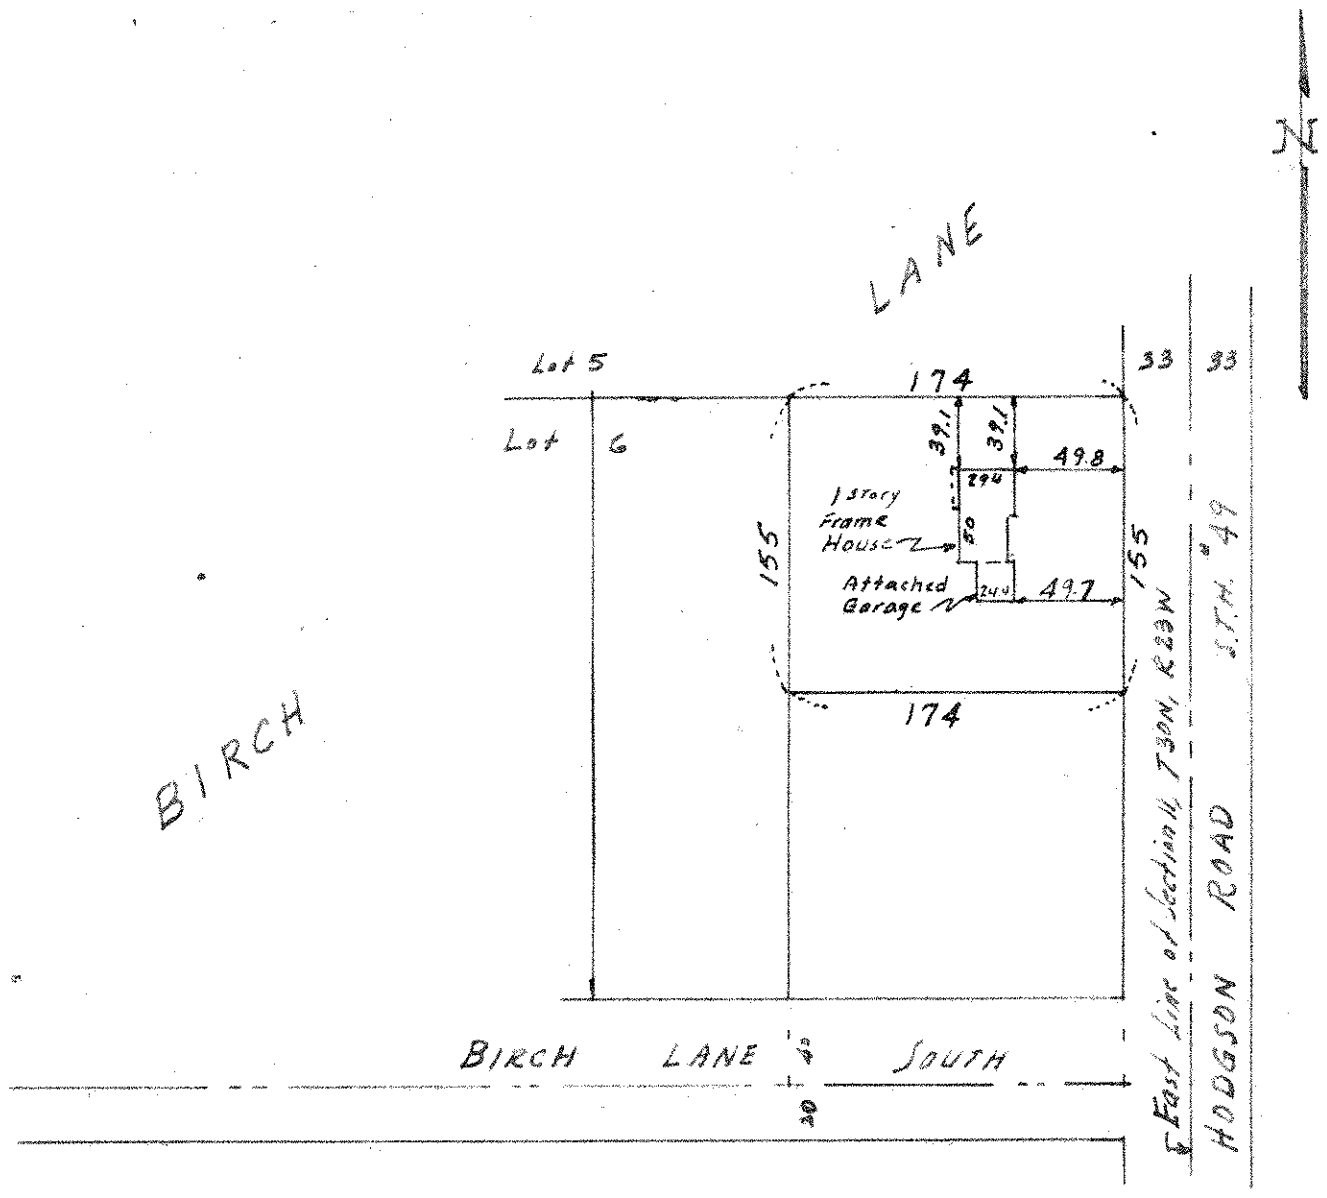
The North 155 feet of the East 174 feet of Lot 6, BIRCH LANE