FROM THE OFFICE OF

Certificate of Survey

## CHARLES O. GEORGI COMPANY

2215 West County Road B

Saint Paul 13, Minnesota

REGISTERED CIVIL ENGINEER AND LAND SURVEYOR

I Hereby Certify that this plat shows a survey made by me of the property described on this plat, and that the corners are correctly placed as shown, and that all locations have been correctly shown.


Surveyed For ALLEN REYNALDS

Date August 1959

Description:

The Northwesterly 135 feet of Lot 2
Block 2
Lake Emily Addition No. 2

By Maile O Stripe REGISTERED LAND SURVEYOR

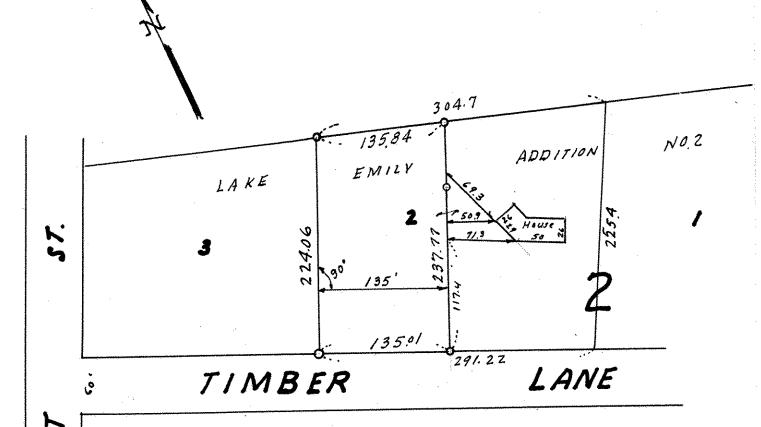

EMMERT

· Denotes Iron Monument.