

14 30 22

FROM THE OFFICE OF

CHARLES O. GEORGI COMPANY

2215 West County Road B

Saint Paul 13, Minnesota

REGISTERED CIVIL ENGINEER AND LAND SURVEYOR

Certificate of Survey



I Hereby Certify that this plat shows a survey made by me of the property described on this plat, and that the corners are correctly placed as shown, and that all locations have been correctly shown.

Surveyed For Mr. L. Pearlman
Date May 1959
Scale 1" = 40'

By Charles O. Georgi
REGISTERED LAND SURVEYOR

Description:

The South 50 feet of Lot 6
Block 63
White Bear
White Bear, Minn.

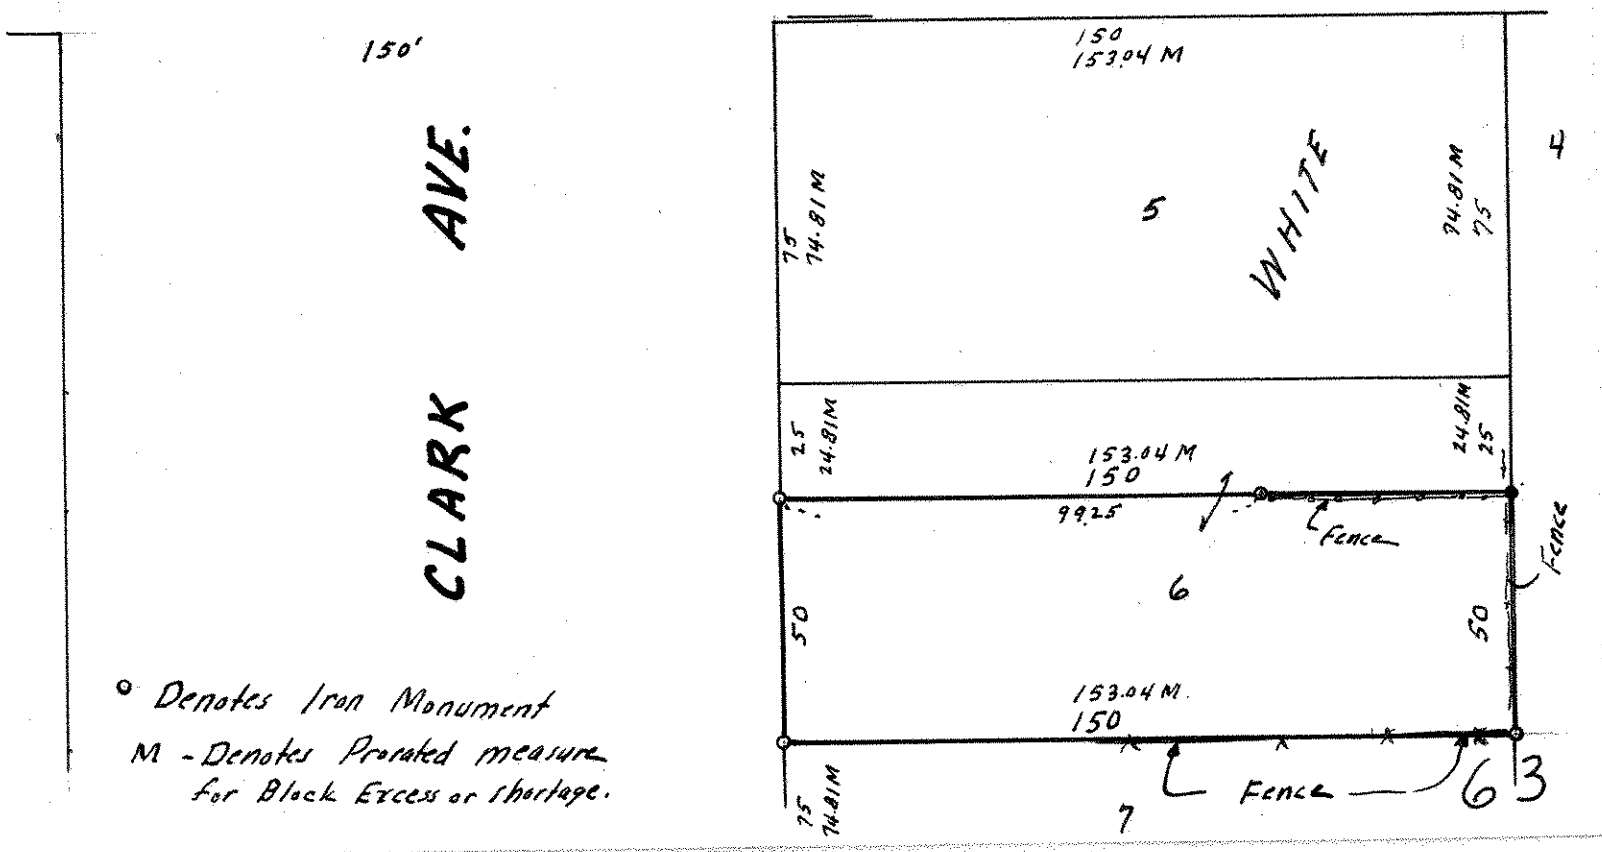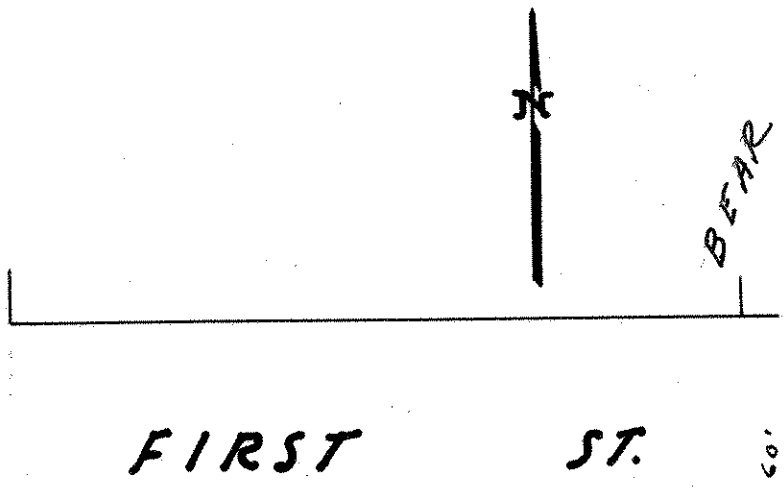

o Denotes Iron Monument
M - Denotes Prorated measure
for Block Excess or shortage.