

FROM THE OFFICE OF

CHARLES O. GEORGI COMPANY

2215 West County Road B

Saint Paul 13, Minnesota

REGISTERED CIVIL ENGINEER AND LAND SURVEYOR

Certificate of Survey

I Hereby Certify that this plat shows a survey made by me of the property described on this plat, and that the corners are correctly placed as shown, and that all locations have been correctly shown.

Surveyed For MR. C. HENDRICKS

Date October 1959


Scale 1" = 50'

By Charles O. Georgi
REGISTERED LAND SURVEYOR

Description:

The East 60 feet of
Lot 5
Block 12
FURNESS' GARDEN LOTS

E. NEBRASKA AVE.

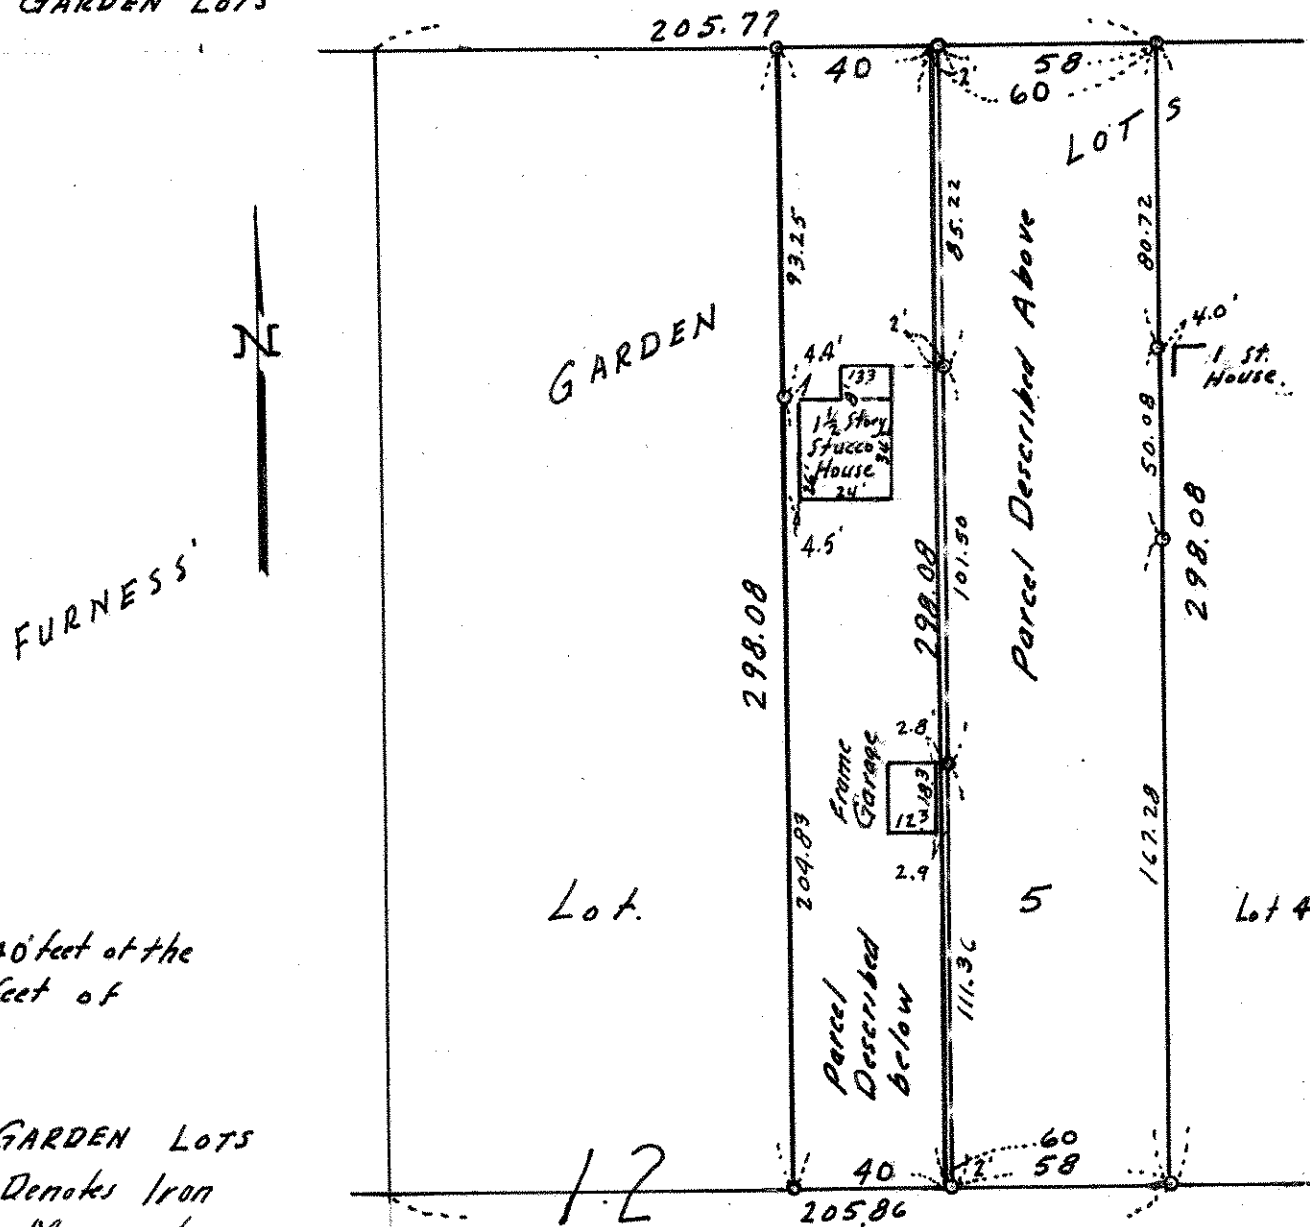

Description:

The West 40 feet of the
East 100 feet of
Lot 5
Block 12
FURNESS' GARDEN LOTS

o Denotes Iron
Monument.