SE 2 2822

FROM THE OFFICE OF

CHARLES O. GEORGI COMPANY

2215 West County Road B Saint Paul 13, Minnesota

REGISTERED CIVIL ENGINEER AND LAND SURVEYOR

Certificate of Survey

I Hereby Certify that this plat shows a survey made by me of the property described on this plat, and that the corners are correctly placed as shown, and that all locations have been correctly shown.

Surveyed For M. BERLAND

Date December 1959

Scale 1" = 50'

Description: By Charles O. Georgi
REGISTERED LAND SURVEYOR

Description:
The West 82 feet of Lots 19 and 20
Block 2
AFTON HEIGHTS ADDITION

The East 82 feet of Lots 1 and 2
Block 2
AFTON HEIGHTS ADDITION

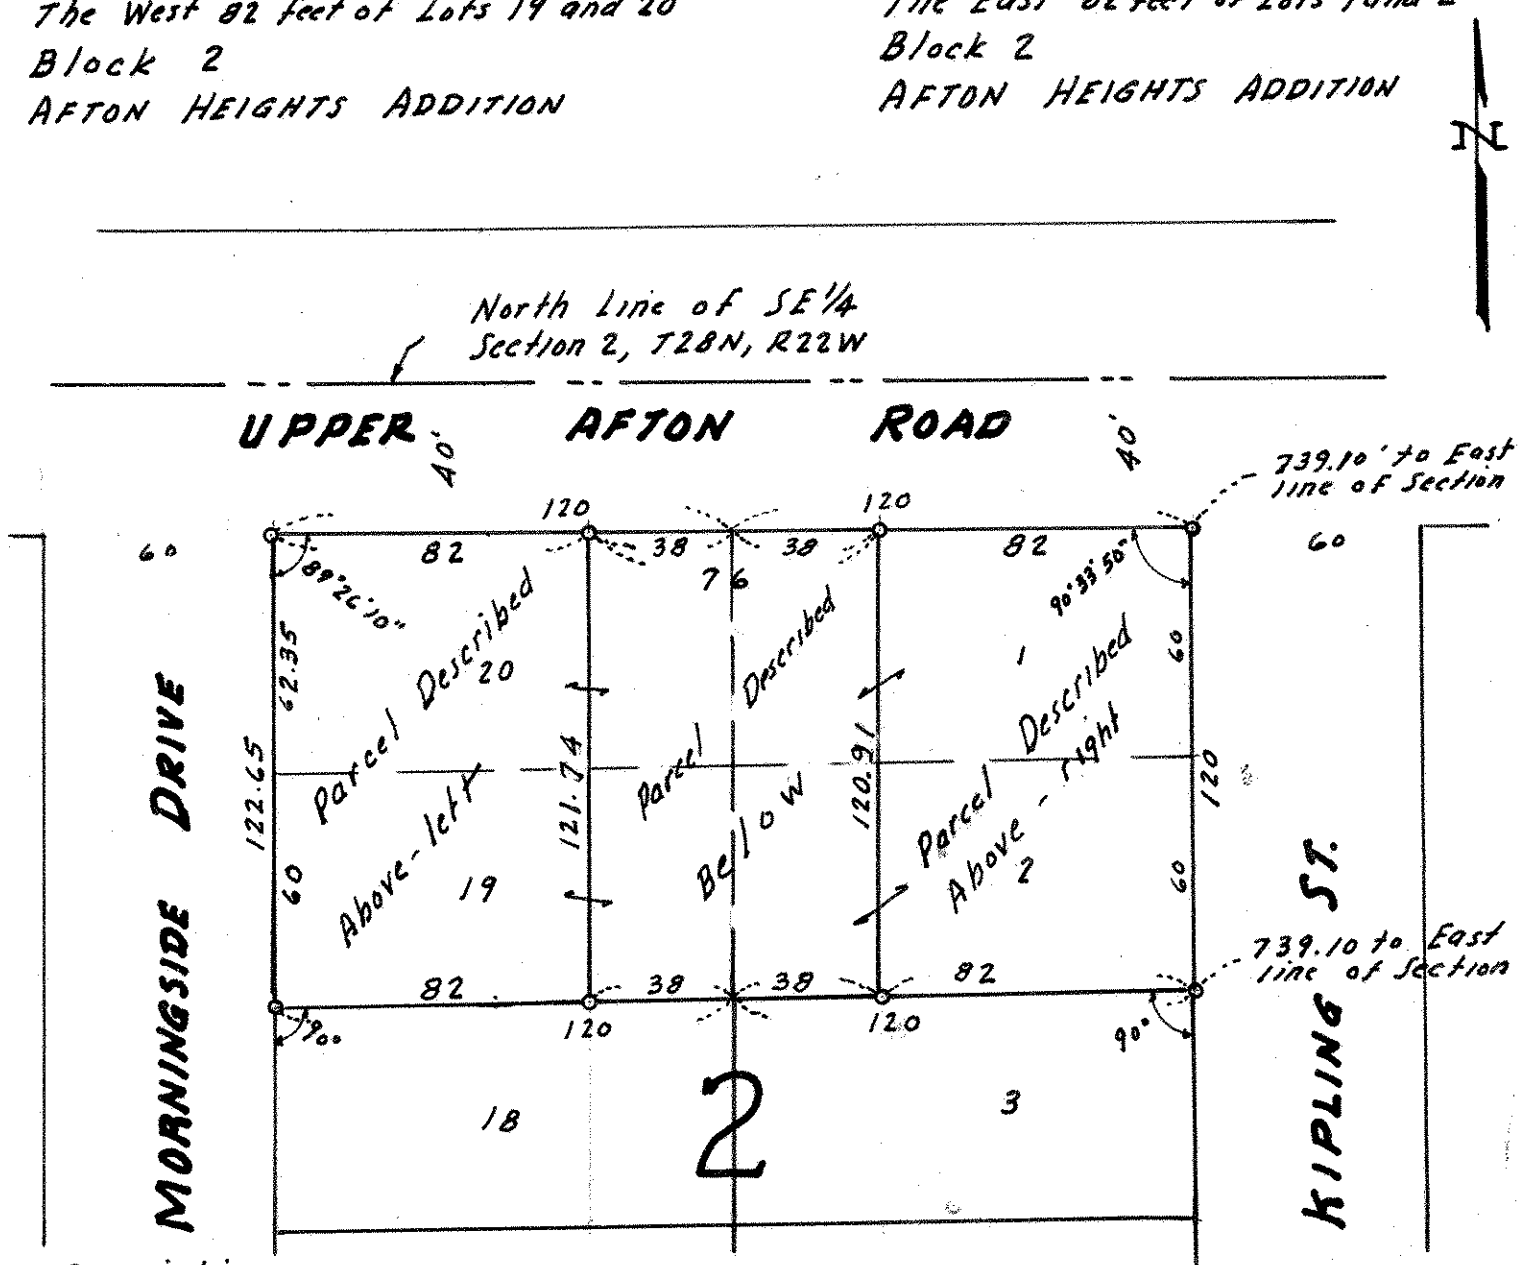

Description:
Lots 19 and 20 except the West 82 feet thereof, and Lots 1 and 2 except the East 82 feet thereof; all in Block 2
AFTON HEIGHTS ADDITION

Note: o Denotes Iron Monument
Above Plat is an approved Preliminary Layout.