FROM THE OFFICE OF

Certificate of Survey

CHARLES O. GEORGI COMPANY

2215 West County Road B

Saint Paul 8, Minnesota

REGISTERED CIVIL ENGINEER AND LAND SURVEYOR

I Hereby Certify that this plat shows a building location survey made by me on the property described on this plat, and that all locations, have been correctly shown.


Date OCTOBER 1960

Charles O. Legge

DONNAY - REITZ Inc. Description: Lot 13

Block 2

AFTON HEIGHTS ADDITION

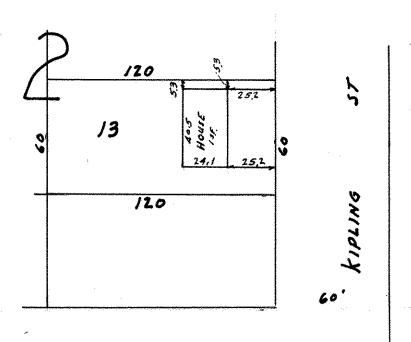

LONGFELLOW AVE