

FROM THE OFFICE OF

CHARLES O. GEORGI COMPANY

2215 West County Road B

Saint Paul 13, Minnesota

REGISTERED CIVIL ENGINEER AND LAND SURVEYOR



I Hereby Certify that this plat shows a survey made by me of the property described on this plat, and that the corners are correctly placed as shown, and that all locations have been correctly shown.

Surveyed For R. ROSELL

Date May 1961

Scale 1" = 50'


By Charles O. Georgi
REGISTERED LAND SURVEYOR

Description:

Lot 3
Block 3
Rosewood



ROSEWOOD LANE S SOUTH

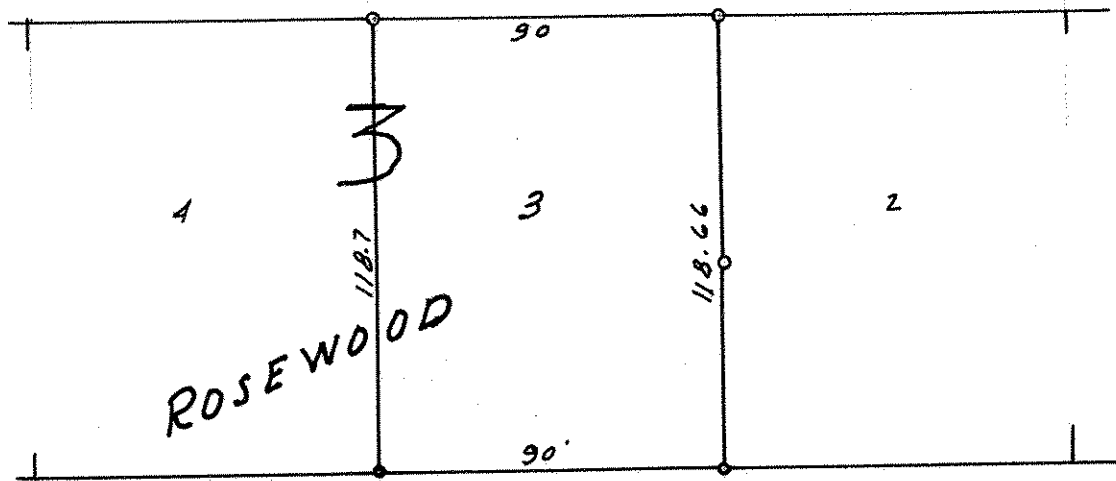

o Denotes Iron Monument.