SE 35 29 22

FROM THE OFFICE OF

CHARLES O. GEORGI COMPANY

2215 West County Road B — Saint Paul 13, Minnesota

REGISTERED CIVIL ENGINEER AND LAND SURVEYOR

Certificate of Survey

I Hereby Certify that this plat shows a survey made by me of the property described on this plat, ~~and that the corners are correctly placed as shown~~, and that all locations have been correctly shown.

Surveyed For Associated Contractors.

Date December 1961

Scale 1"=100'

By Charles O. Georgi
REGISTERED LAND SURVEYOR
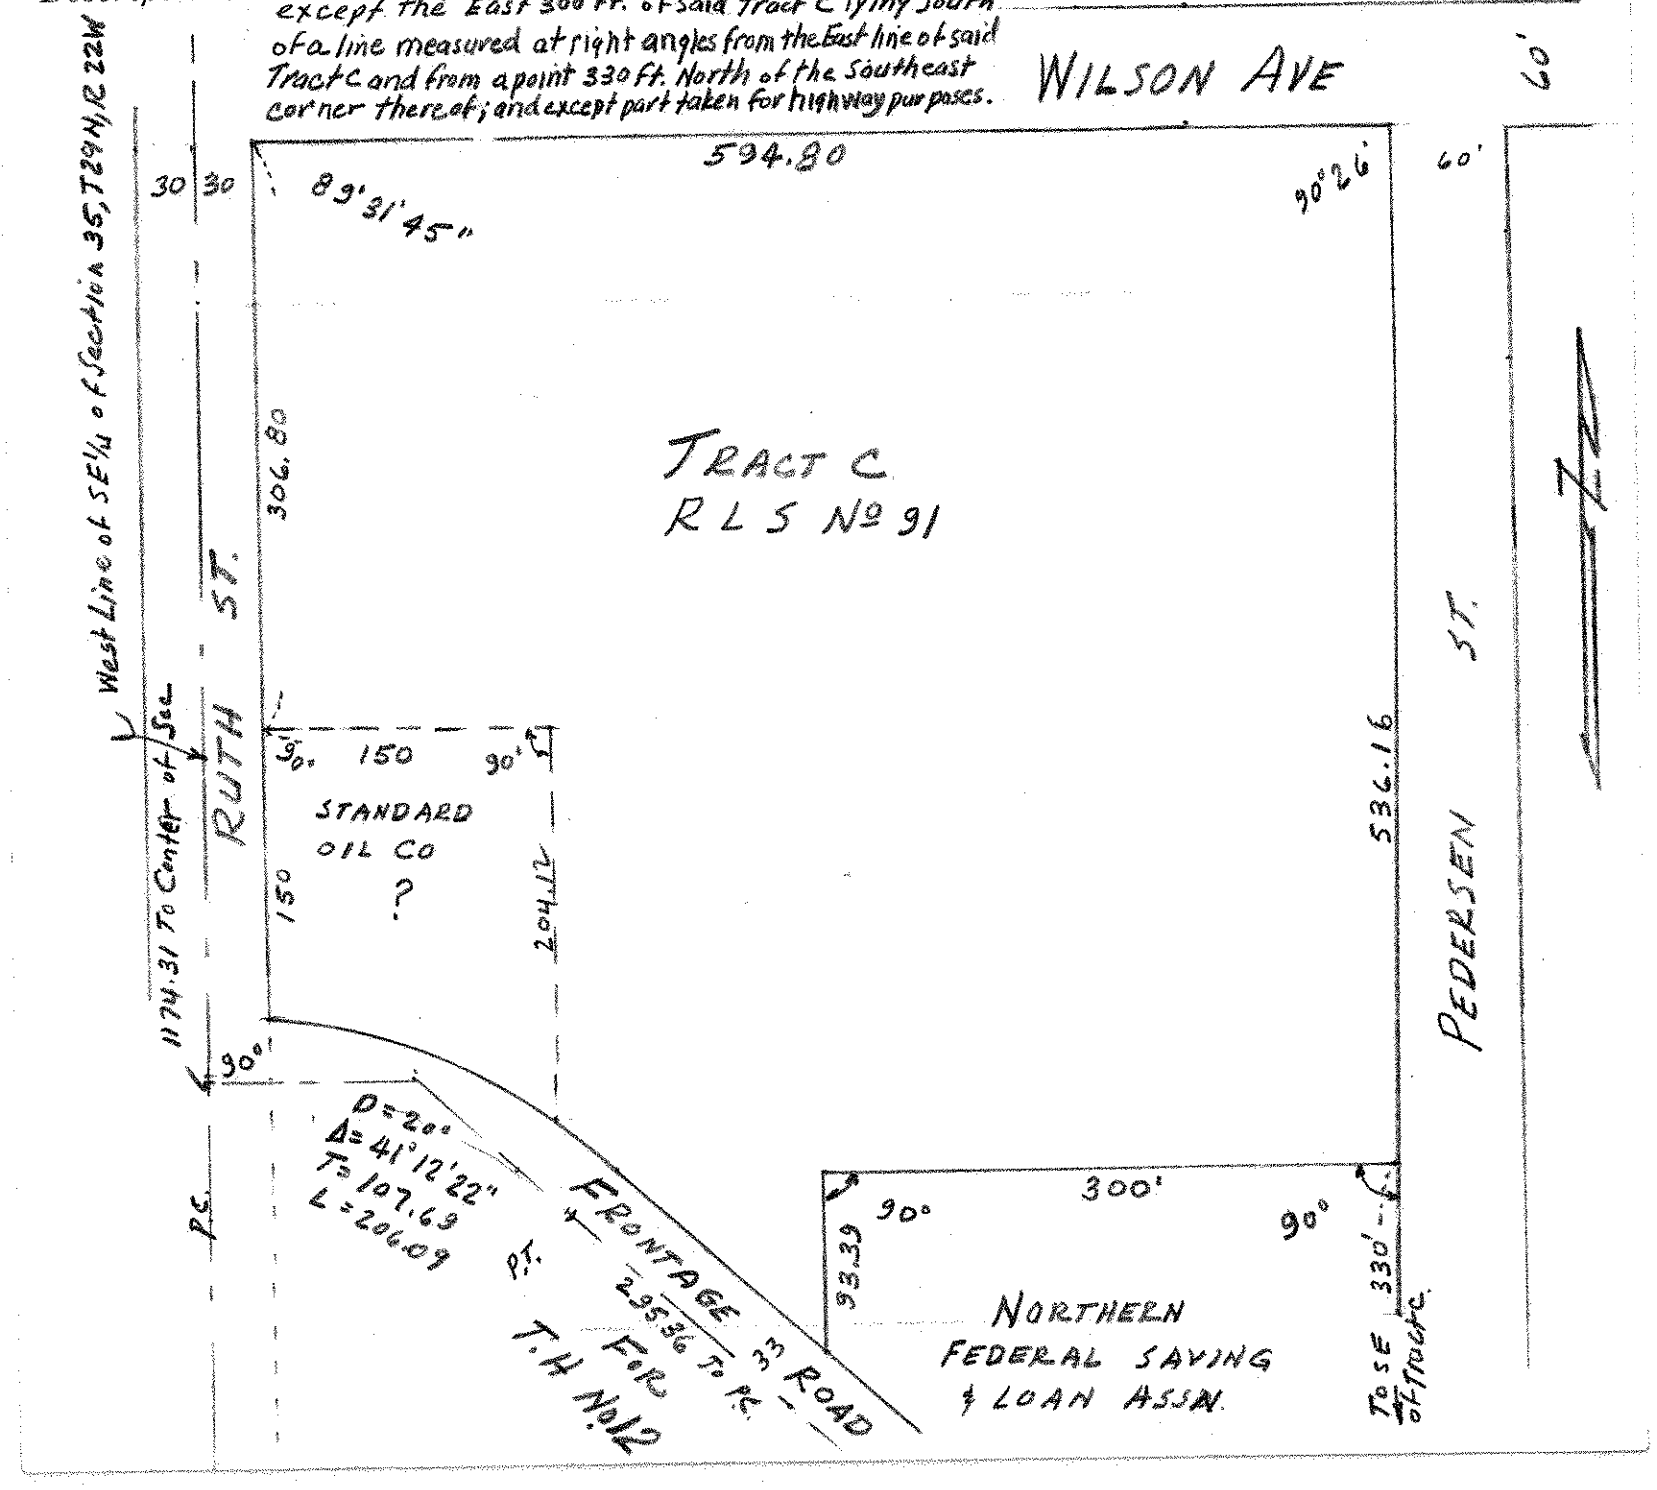
Description: Tract C, Registered Land Survey No 31 except the East 300 ft. of said Tract C lying South of a line measured at right angles from the East line of said Tract C and from a point 330 ft. North of the Southeast corner thereof; and except part taken for highway purposes.