FROM THE OFFICE OF

Certificate of Survey

DONNAY-REITE INC.

Description:

Lot 25

BlockI

Afton Heights Addition

CHARLES O. GEORGI COMPANY

2215 West County Road B

Saint Paul 8, Minnesota


REGISTERED CIVIL ENGINEER AND LAND SURVEYOR

I Hereby Certify that this plat shows a building location survey made by me on the property described on this plat, and that all locations, have been correctly shown.

Date February 1961

Seale 1" =50

Charles O Leone

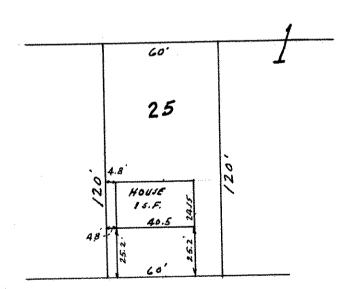

DELLRIDGE

AVE.