## Certificate of Survey

DONNAY - REITE INC.

Description:

Lot 24

Block

Afton Heights Addition

CHARLES O. GEORGI COMPANY

2215 West County Road B


Saint Paul 8, Minnesota

REGISTERED CIVIL ENGINEER AND LAND SURVEYOR

I Hereby Certify that this plat shows a building location survey made by me on the property described on this plat, and that all locations, have been correctly shown.

Date February 1941

Scale 1" = ....50'

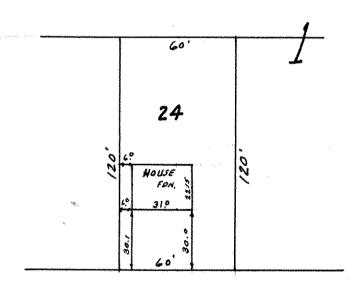

DELLRIDGE

AVE.