FROM THE OFFICE OF

Gertificate
of Survey

DONNAY- REITE INC.

Description:

Lot 29

BlockI

Afton Heights Addition

CHARLES O. GEORGI COMPANY

2215 West County Road B

Saint Paul 8, Minnesota


REGISTERED CIVIL ENGINEER AND LAND SURVEYOR

I Hereby Certify that this plat shows a building location survey made by me on the property described on this plat, and that all locations, have been correctly shown.

Date February 1961

Scale 1" = 50'

BEGISTERED LAND SURVEYOR

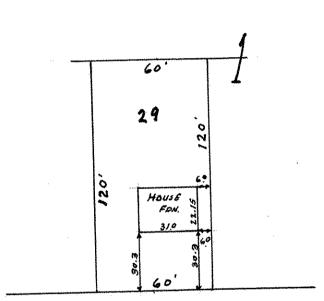

DELLRIDGE

O AVE