FROM THE OFFICE OF

Certificate of Survey

CHARLES O. GEORGI COMPANY

2215 West County Road B

Saint Paul 13, Minnesota

REGISTERED CIVIL ENGINEER AND LAND SURVEYOR

I Hereby Certify that this plat shows a survey made by me of the property described on this plat, and that the corners are correctly placed as shown, and that all locations have been correctly shown.

Surveyed For DONNAY - REITZ


Date June 196/
Scale I"=100'

By Sale Derge

Description:

Block 3

AFTON HEIGHTS ADDITION

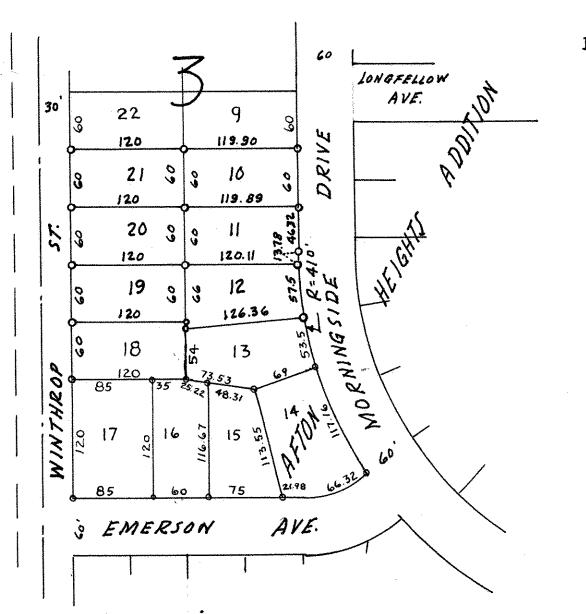

o Denotes Iron Monument.