

FROM THE OFFICE OF

CHARLES O. GEORGI COMPANY

2215 West County Road B

Saint Paul 13, Minnesota

REGISTERED CIVIL ENGINEER AND LAND SURVEYOR

**Certificate
of Survey**

I Hereby Certify that this plat shows a survey made by me of the property described on this plat, and that the corners are correctly placed as shown, and that all locations have been correctly shown.

Surveyed For *Mr. James Haluptzok*


Date *March 1962*

Scale *1" = 100'*

By *Charles O. Georgi*
REGISTERED LAND SURVEYOR

Description:

*The North 1/2 of Lot 21,
SPRING LAKE PARK HILLVIEW
Ramsey County, Minn.*

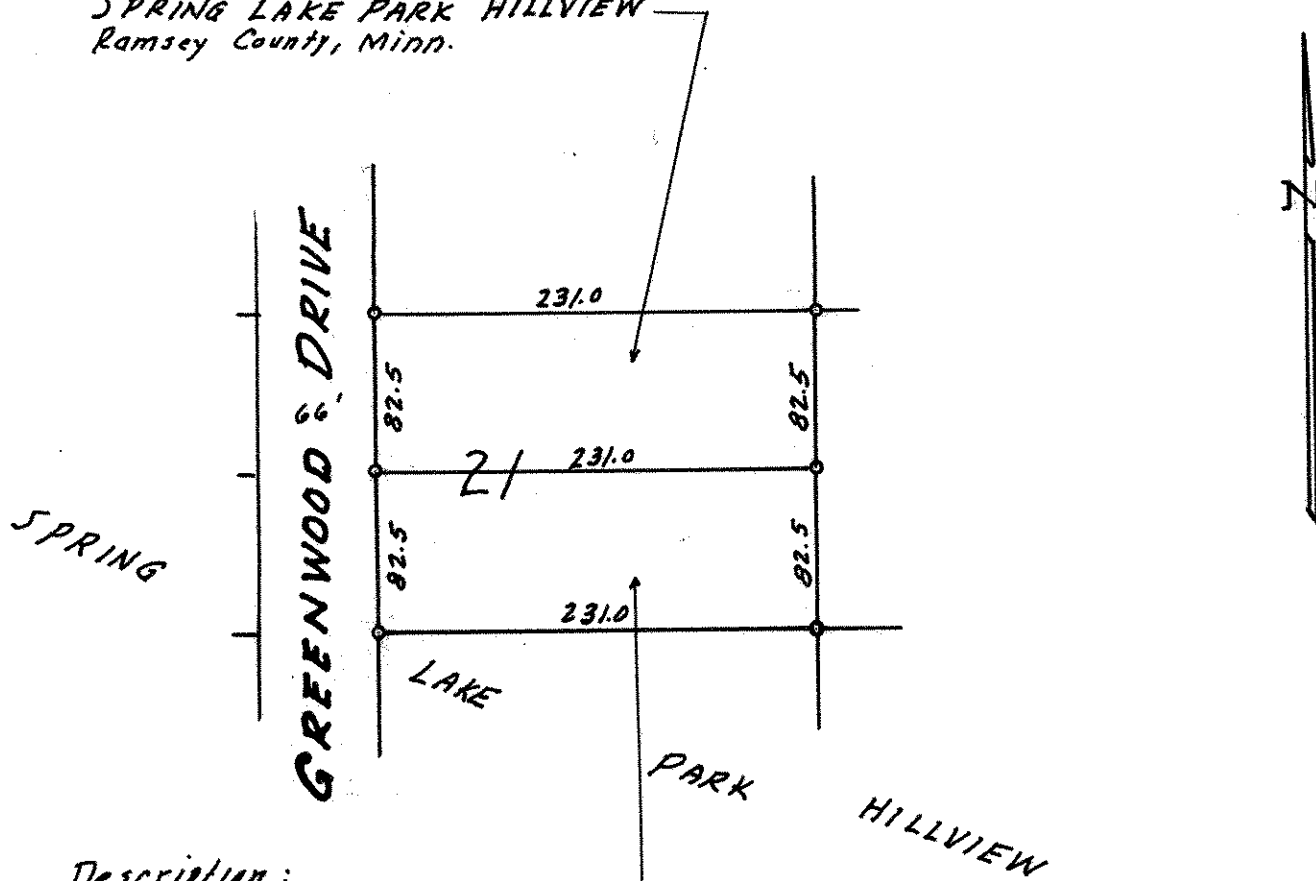

Description:
*The South 1/2 of Lot 21
SPRING LAKE PARK HILLVIEW
Ramsey County, Minn.*

o Denotes Iron Monument