

SE 27 2922

FROM THE OFFICE OF

# CHARLES O. GEORGI COMPANY

2215 West County Road B

Saint Paul 13, Minnesota

REGISTERED CIVIL ENGINEER AND LAND SURVEYOR

## Certificate of Survey

I Hereby Certify that this plat shows a survey made by me of the property described on this plat, and that the corners are correctly placed as shown, and that all locations have been correctly shown.

Surveyed For *Angelo A. Aschittino*


Date.....*May 1962*.....

Scale.....*1"=50'*.....

By *Charles O. Georgi*  
REGISTERED LAND SURVEYOR

**Description:**

*The West 20 feet of Lot 7 and  
the East 30 feet of Lot 8.  
Block 2  
Birmingham Park.*

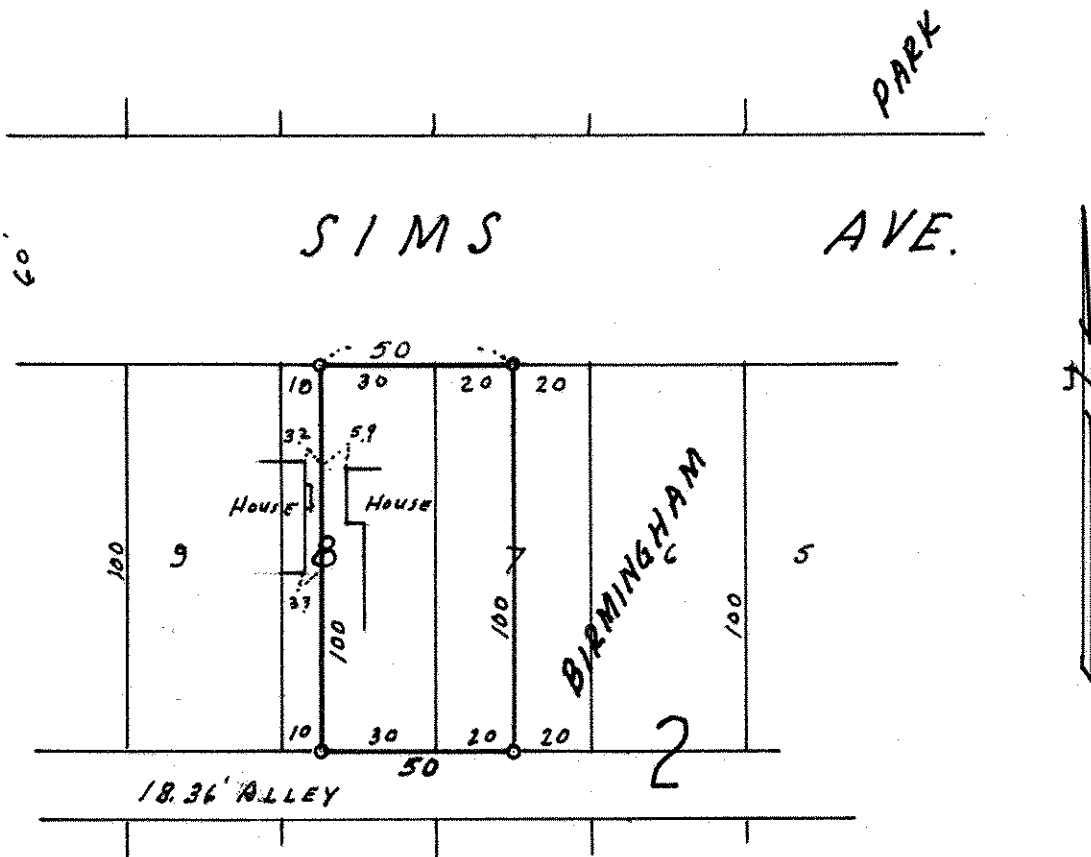

o Denotes Iron Monument.