FROM THE OFFICE OF

## Certificate of Survey

## CHARLES O. GEORGI COMPANY

2215 West County Road B

Saint Paul 13, Minnesota

REGISTERED CIVIL ENGINEER AND LAND SURVEYOR

I Hereby Certify that this plat shows a survey made by me of the property described on this plat, and that the corners are correctly placed as shown, and that all locations have been correctly shown.

Surveyed For EDNA BENSAN

Date May 1962

Scale 1"= 50

Description: The East 63 feet of the West 163 feet of Lot 1

and the East 50 feet of the West 150 feet of Lot 2


Block 153

80'

WEST ST. PAUL PROPER

## E. CURTICE

ST.

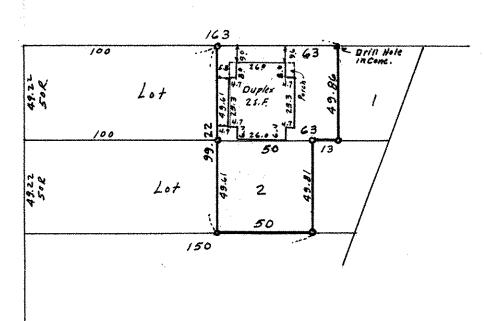

· Denotes Iron Monument.
R Denotes Record measure as per plat.