## Certificate of Survey

## CHARLES O. GEORGI COMPANY

2215 West County Road B

Saint Paul 13, Minnesota

REGISTERED CIVIL ENGINEER AND LAND SURVEYOR

I Hereby Certify that this plat shows a survey made by me of the property described on this plat, and that the corners are correctly placed as shown, and that all locations have been correctly shown.

Surveyed For Miss Jodie Nobbe


Date Sept. 1963

Scale "= 50"

Description:

Lot 12, Block 6, Fletchers Subdivision.

Above subject to Alley over the Westerly 5 feet thereof.

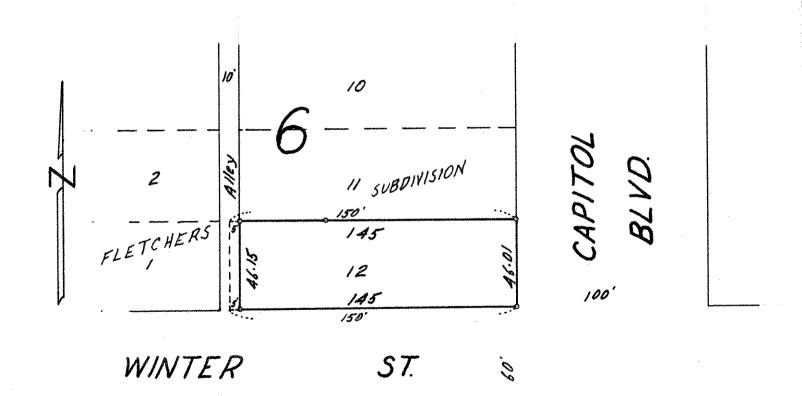

· Denotes Iron Monument