


FROM THE OFFICE OF

CHARLES O. GEORGI COMPANY

2215 West County Road B

Saint Paul 13, Minnesota

REGISTERED CIVIL ENGINEER AND LAND SURVEYOR



**Certificate
of Survey**

I Hereby Certify that this plat shows a survey made by me of the property described on this plat, and that the corners are correctly placed as shown, and that all locations have been correctly shown.

Surveyed For J.R. Walker - Ali Khambata

Date..... June 1963

Scale..... 1" = 50'


By



REGISTERED LAND SURVEYOR

Description:

The South 40 feet of Lot 4 and the North 50 feet of Lot 5, Block 3, South Battle Creek Heights.

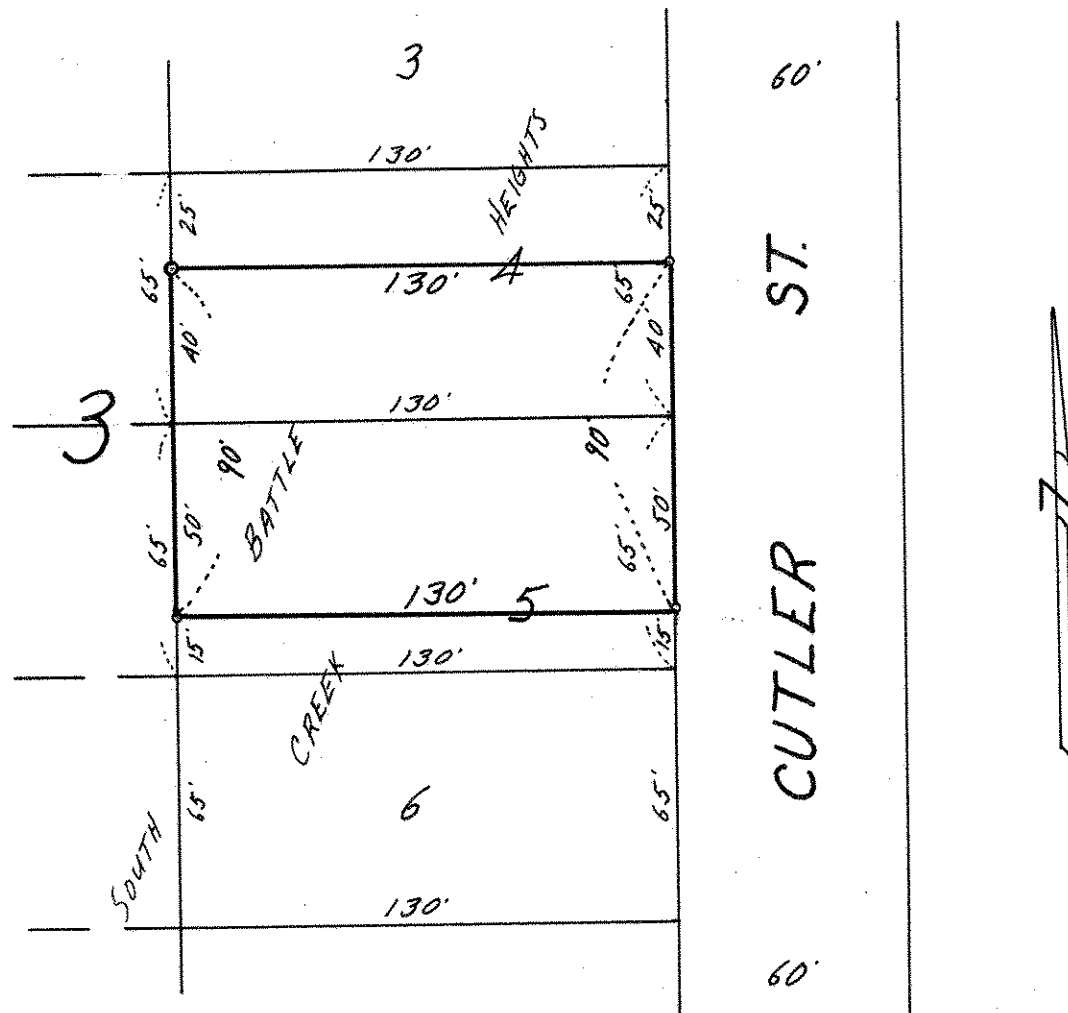

o Denotes Iron Monument