


PLAT OF SURVEY

OF PROPERTY OF _____
 DESCRIBED AS FOLLOWS Lots 27-28-29-30-31-32 and 33 Block 6 Burlington
Heights Division No 1

SCALE: 1 INCH = 100 FEET
 ○ DENOTES IRON

T. J. WELCH, REGISTERED SURVEYOR
 738 SURREY AVENUE, ST. PAUL 6, MINN.

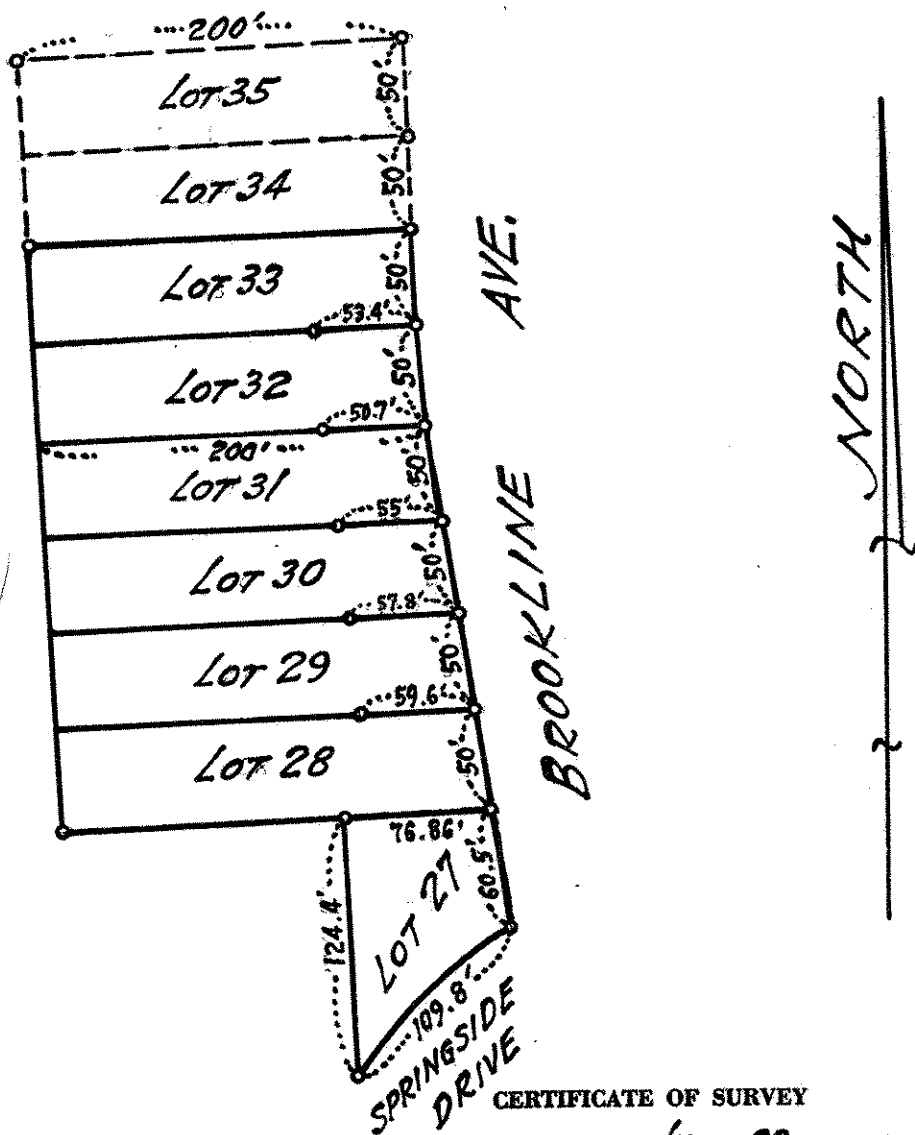

CERTIFICATE OF SURVEY

I hereby certify that on June 22, 1963
 I surveyed the property described above and that the above
 plat is a correct representation of said survey.

T. J. Welch