Phone: MRW4, 200484

(Evenings Collect)

P. E. HIGHUM

Registered Professional Engineer and Land Surveyor

1275 St. Paul Avenue

St. Paul 16, Minnesota


PLAT OF SURVEY

OF PROPERTY OF RONALD DUNCAN

described as follows: NORTH HALF OF LOT 22 ALL OF LOT 23 & SOUTH HALF LOT 24

BLOCK 11 PLAT 2 EDWIN M. WARES CUMBERLAND ADDITION

CITY OF ST. PAUL, RAMSEY COUNTY, STATE OF MINNESOTA

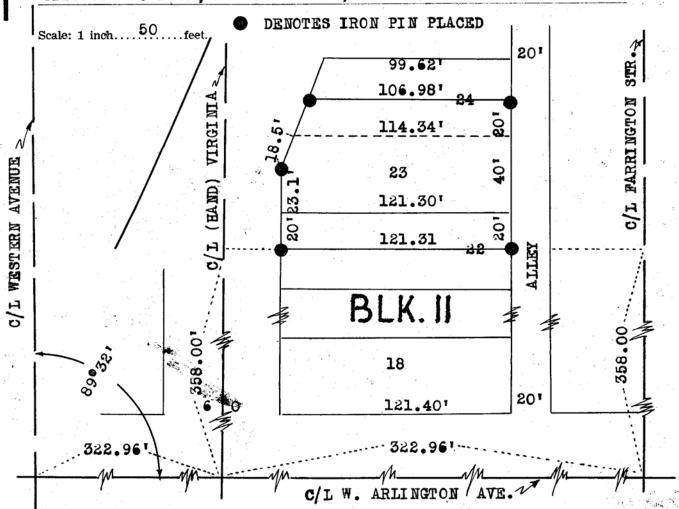

CERTIFICATE OF LOCATION OF BUILDING

CERTIFICATE OF SURVEY

1538 MINN REG NO.