699-0484

Phone: MIdway 9-0484

(Evenings Collect)

described as follows:

P. E. HIGHUM

Registered Professional Engineer and Land Surveyor

1275 St. Paul Avenue


St. Paul 16, Minnesota

PLAT OF SURVEY

OF PROPERTY OF LOUIS L. URMANN 1596 WOODBRIDGE

LOT 24 BLOCK 7 RICE STREET VILLA ADDITION

CITY OF ST. PAUL, RAMSEY COUNTY, MINNESOTA

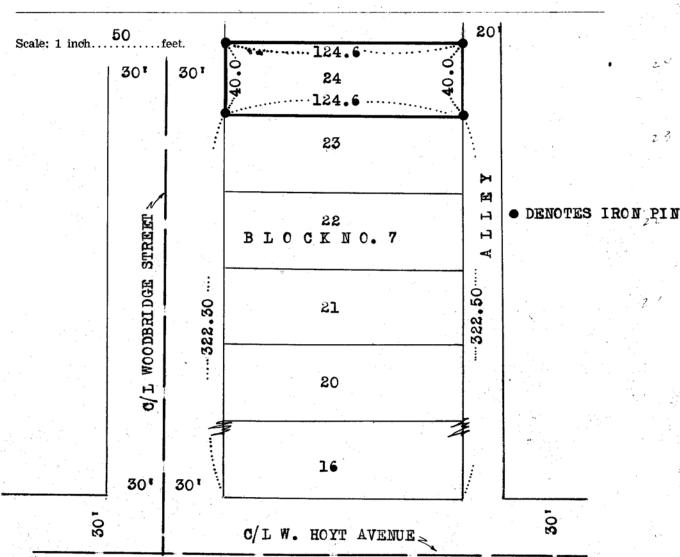

CERTIFICATE OF LOCATION OF BUILDING

CERTIFICATE OF SURVEY

I hereby certify that on. NOV. 7...., 19.64 I surveyed the property described above and that the above plat is a correct representation of said survey.

MINN. REG. NO. 1538