699-0584

Phone: Mikhway 9 0184

(Evenings Collect)

P. E. HIGHUM

Registered Professional Engineer and Land Surveyor

1275 St. Paul Avenue St. Paul 16, Minnesota

PLAT OF SURVEY


OF PROPERTY OF R.L. JANNSEN 1319 HUBBARD AVENUE

described as follows: LOT 7 PANIAN ADDITION

CITY OF ST. PAUL, RAMSEY COUNTY, MINNESOTA

Scale: 1 inch.....50 feet.

• INDICATES IRON PIN

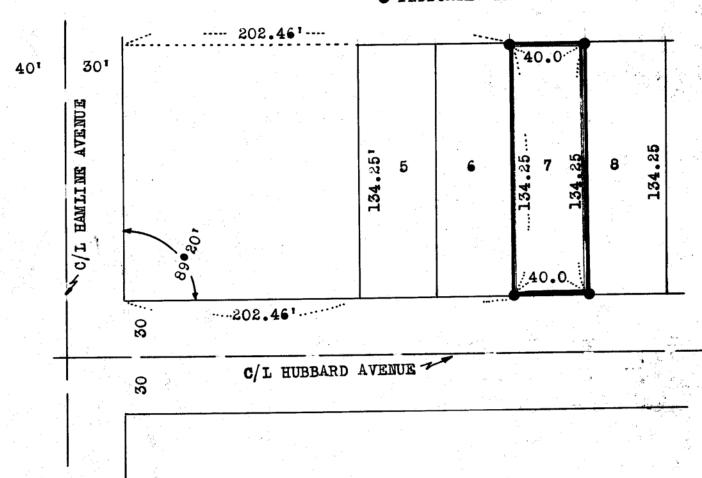

CERTIFICATE OF LOCATION OF BUILDING

CERTIFICATE OF SURVEY

I hereby certify that on.. JUNE.20..., 19.641 surveyed the property described above and that the above plat is a correct representation of said survey.

MINN. REG. NO.1538