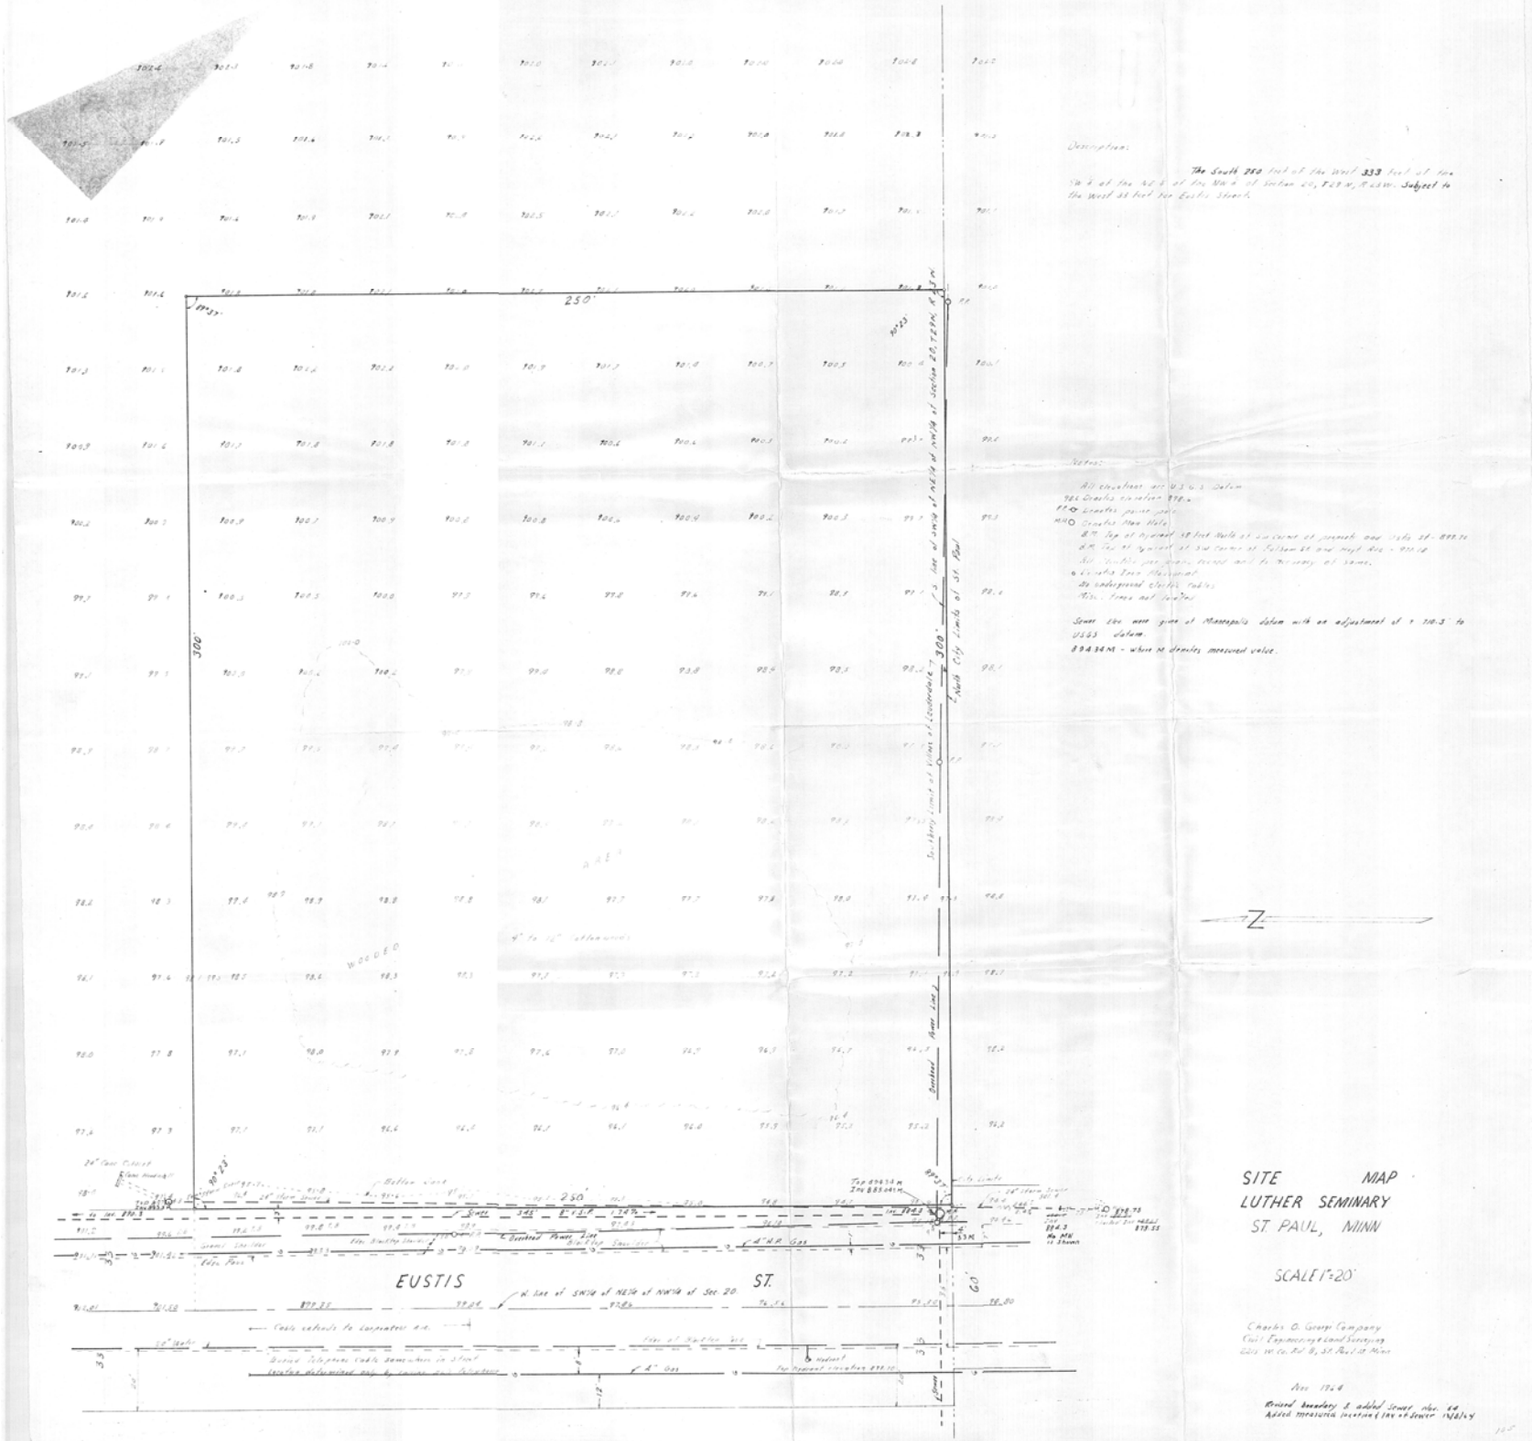
Description:
The South 250 feet of the West 333 feet of the N½ of the NE¼ of the NW¼ of Section 20, T28 N, R 23 W. Subject to the west 33 feet for Eustis Street.
250'
300'
EUSTIS ST.
SITE MAP
LUTHER SEMINARY
ST. PAUL, MINN
SCALE 1"=20'
Charles O. Gerogi Company
Civil Engineering & Land Surveying
Wm. W. Co. Rd B, St. Paul, St. Minn