FROM THE OFFICE OF

CHARLES O. GEORGI COMPANY

2215 West County Road B Saint Paul 8, Minnesota

MINNESOTA REGISTERED LAND SURVEYOR

Certificate of Survey

I Hereby Certify that this plat shows a survey made by me of the property described on this plat, and that the corners are correctly placed as shown, and that all locations, encroachments, etc., have been correctly shown.

Surveyed For CLARK OIL

Date Sept 11, 1964

Scale 1" = 30'

By Charles O. Georgi

REGISTERED LAND SURVEYOR

DESCRIPTION:

Parcel 1

The Northerly 46 feet of Lot 4, Block 13, Brunsons Addition to the Town of St. Paul.

Parcel 2

All that part of Lots 5, 6 and 7, Block 12, Brunsons Addition to the town of St. Paul, lying Southerly of the Southeasterly right-of-way of E. 7th St. as widened to an 80 foot width.

All of vacated Grove St. adjoining above said Lots 5, 6 and 7 and the South ½ of vacated Grove St. adjoining Lot 1, Block 13, Brunsons Addition to the Town of St. Paul.

All of Lots 1, 2 and 3, Block 13, Brunsons Addition to the Town of St. Paul, except that part of Lot 1 taken for Highway purposes.

NOTE:
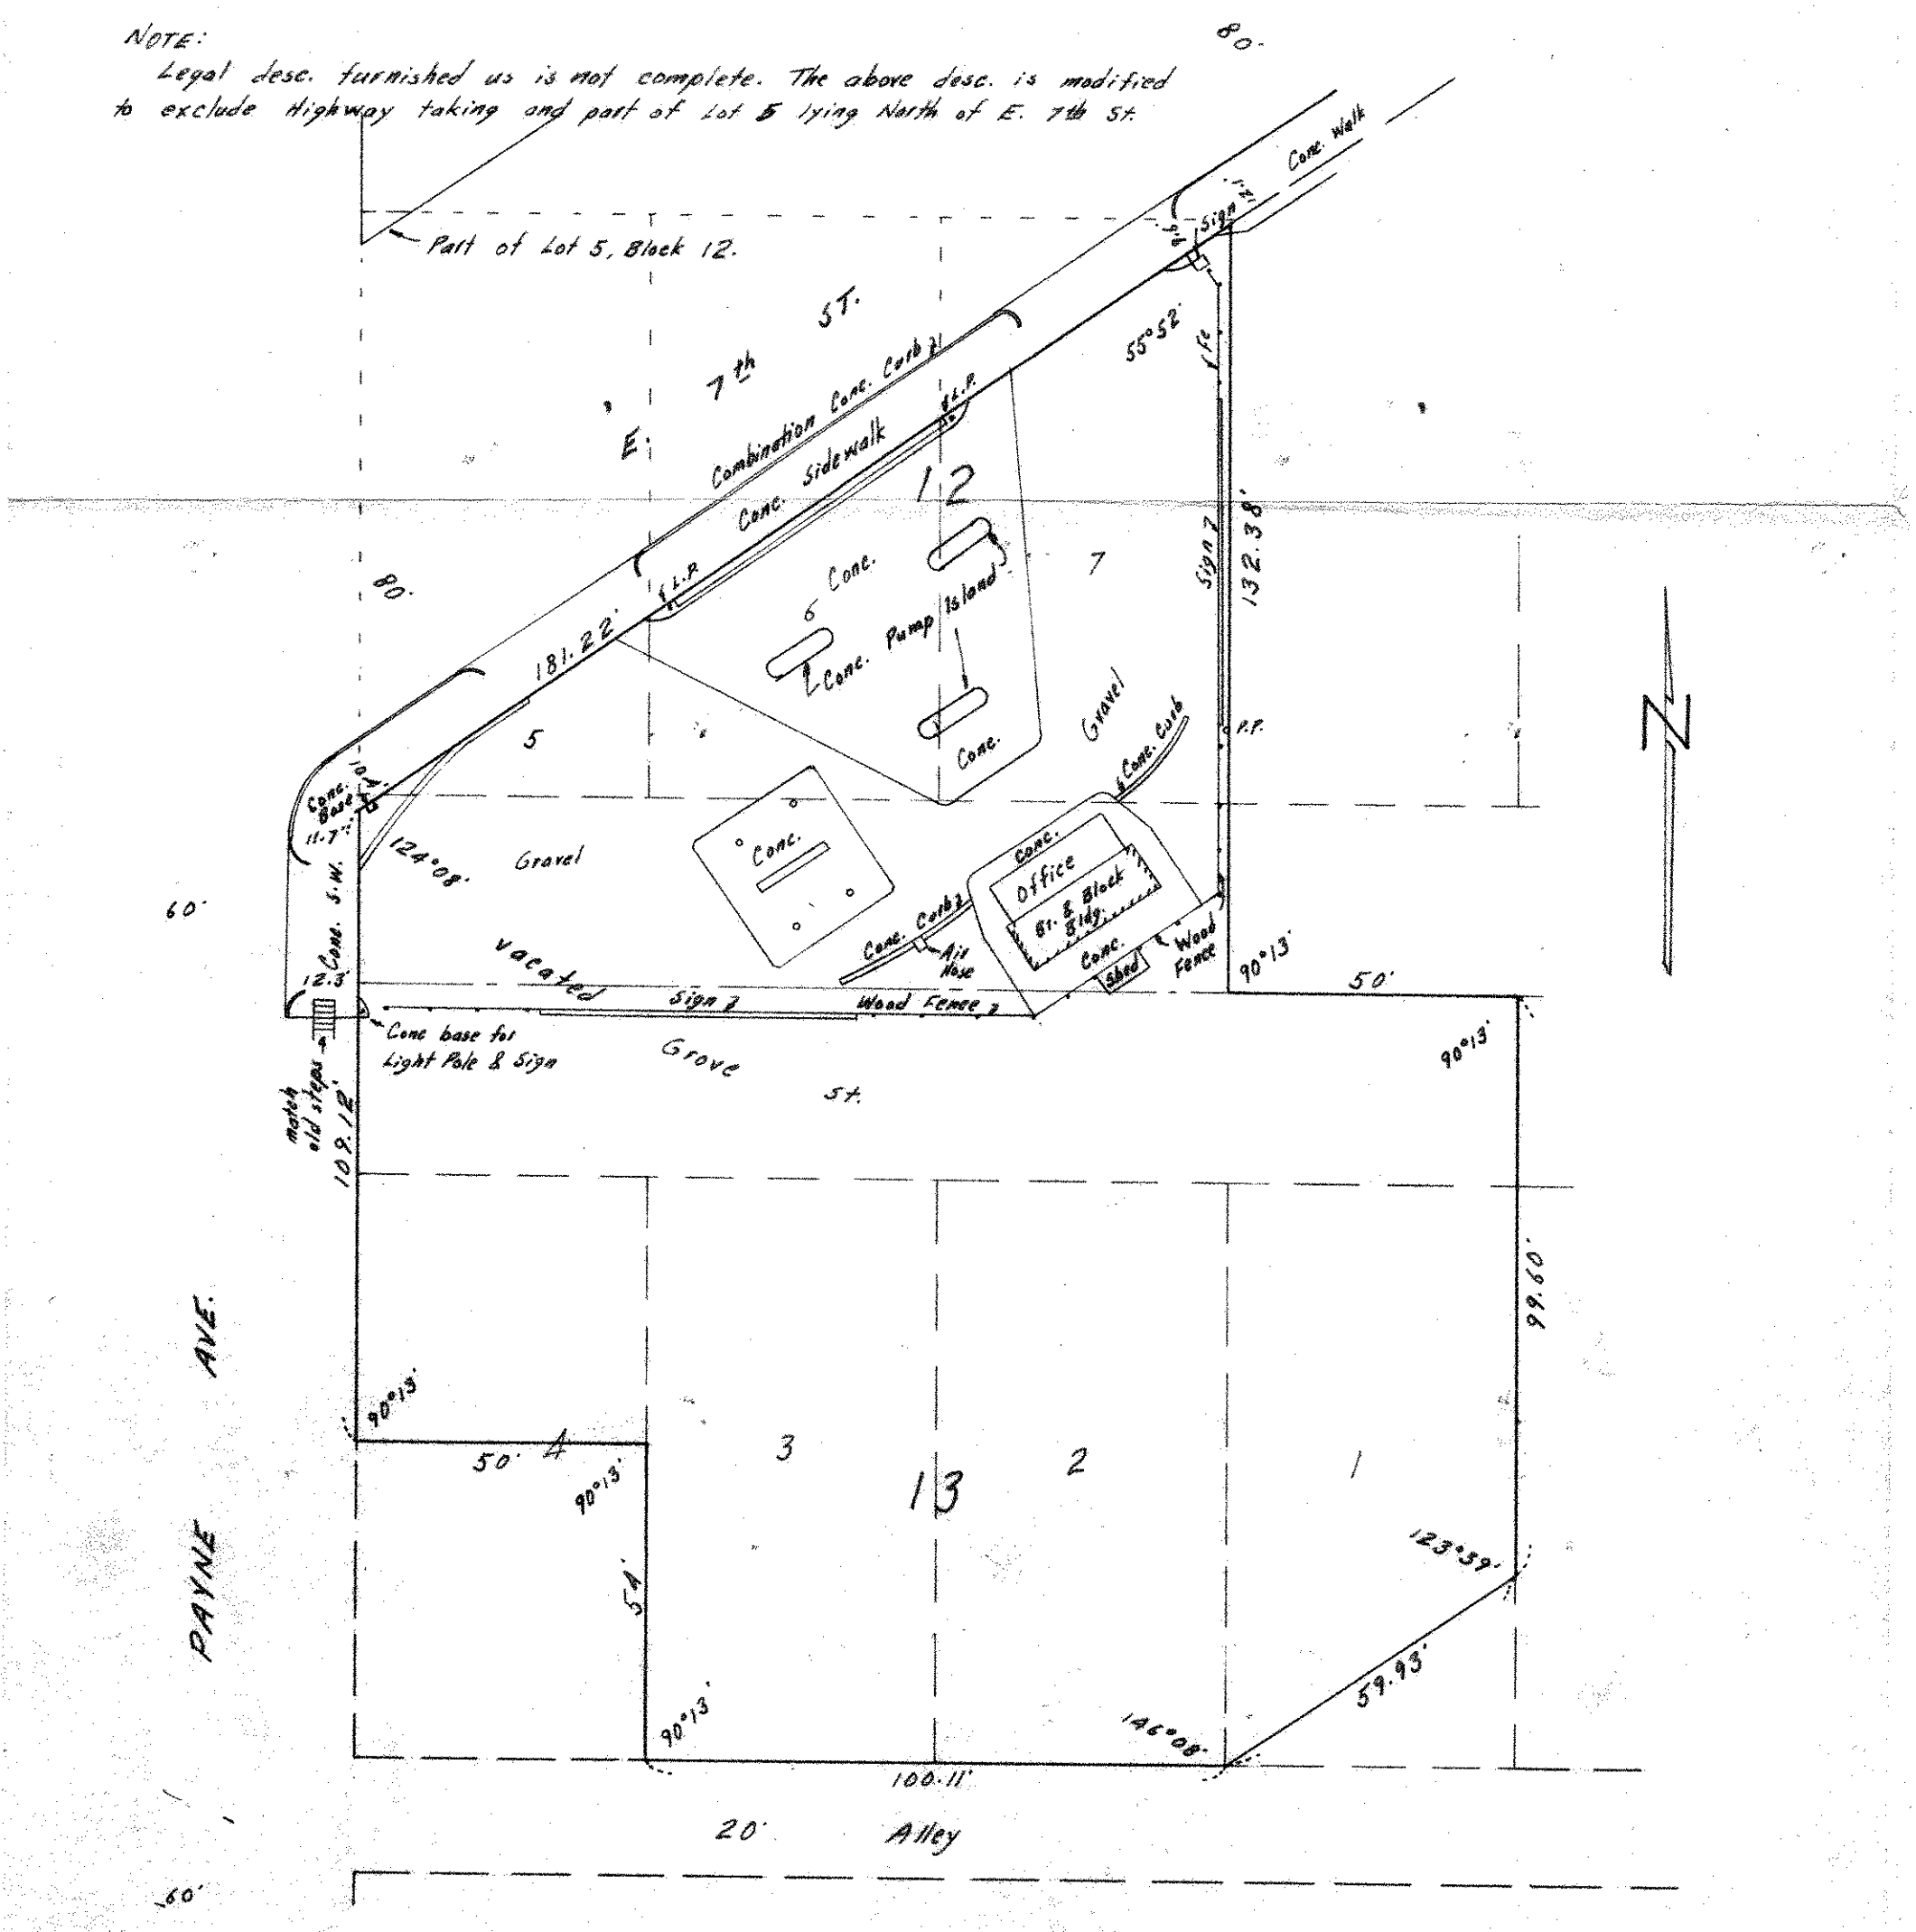
Legal desc. furnished us is not complete. The above desc. is modified to exclude highway taking and part of Lot 5 lying North of E. 7th St.