FROM THE OFFICE OF

CHARLES O. GEORGI COMPANY

2215 West County Road B — Saint Paul 8, Minnesota

REGISTERED CIVIL ENGINEER AND LAND SURVEYOR

Certificate of Survey

I Hereby Certify that this plat shows a building and improvements location survey made by me on the property described on this plat, and that all locations, have been correctly shown.

Date Sept 11 1964

Scale 1" = 30'

By [signature]
REGISTERED LAND SURVEYOR

Clark 311

Description:
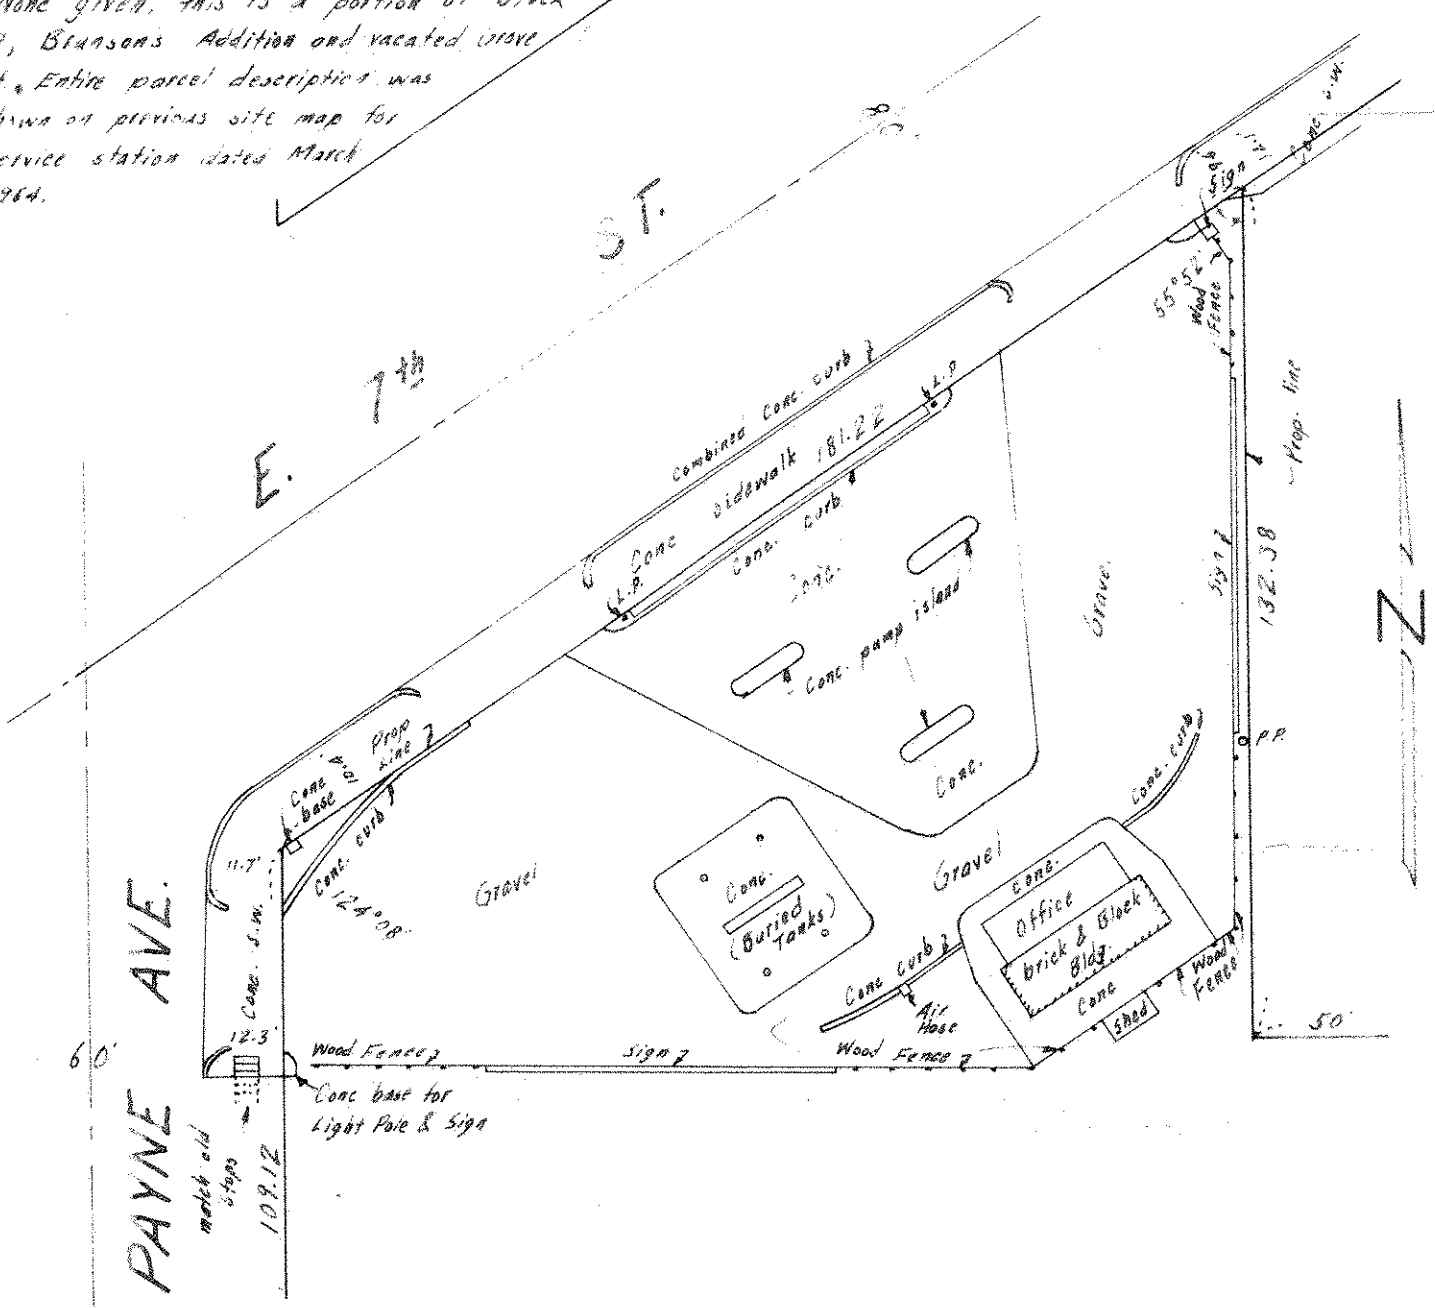
None given, this is a portion of Block 12, Brunsons Addition and vacated Grove St. Entire parcel description was shown on previous site map for service station dated March 1964.