SW 33, 29, 22

FROM THE OFFICE OF

# CHARLES O. GEORGI COMPANY

2215 West County Road B Saint Paul 13, Minnesota

REGISTERED CIVIL ENGINEER AND LAND SURVEYOR

## Certificate of Survey

*I Hereby Certify that* this plat shows a survey made by me of the property described on this plat, and that the corners are correctly placed as shown, and that all locations have been correctly shown.

*Surveyed For* Dole Reeves

*Date* April 1964

*Scale* 1" = 50'

By Charles O. Georgi
REGISTERED LAND SURVEYOR

*Description:*

Lot 18
Block 78
L. Warner's Sub

Lot 18
L. Warner's Subdivision of
Block 78, Lyman Daytons Add.

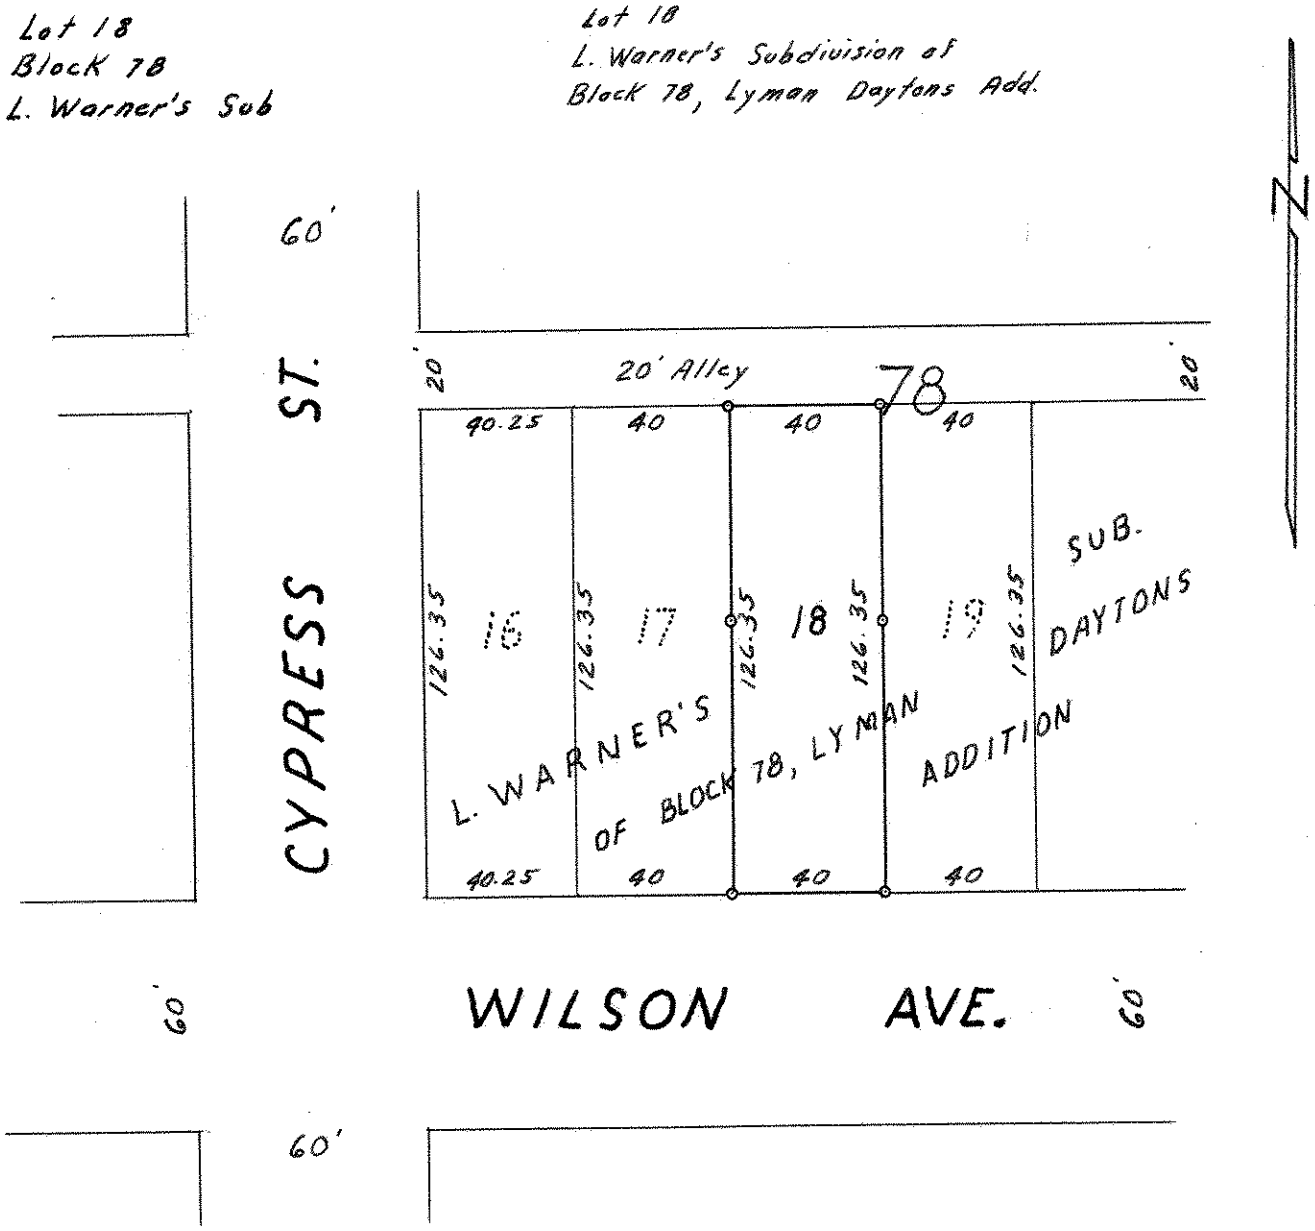


∘ Denotes Iron Monument