

# PLAT OF SURVEY

OF PROPERTY OF: WILLIAM HUNT (1748 MARSHALL)

DESCRIBED AS FOLLOWS:


LOT 5 BLOCK 1

SKIDMORE & CASSIDY ADDITION

CITY OF ST. PAUL, RAMSEY COUNTY, MINNESOTA

■ DENOTES WOODEN NAIL

● DENOTES IRON PIN

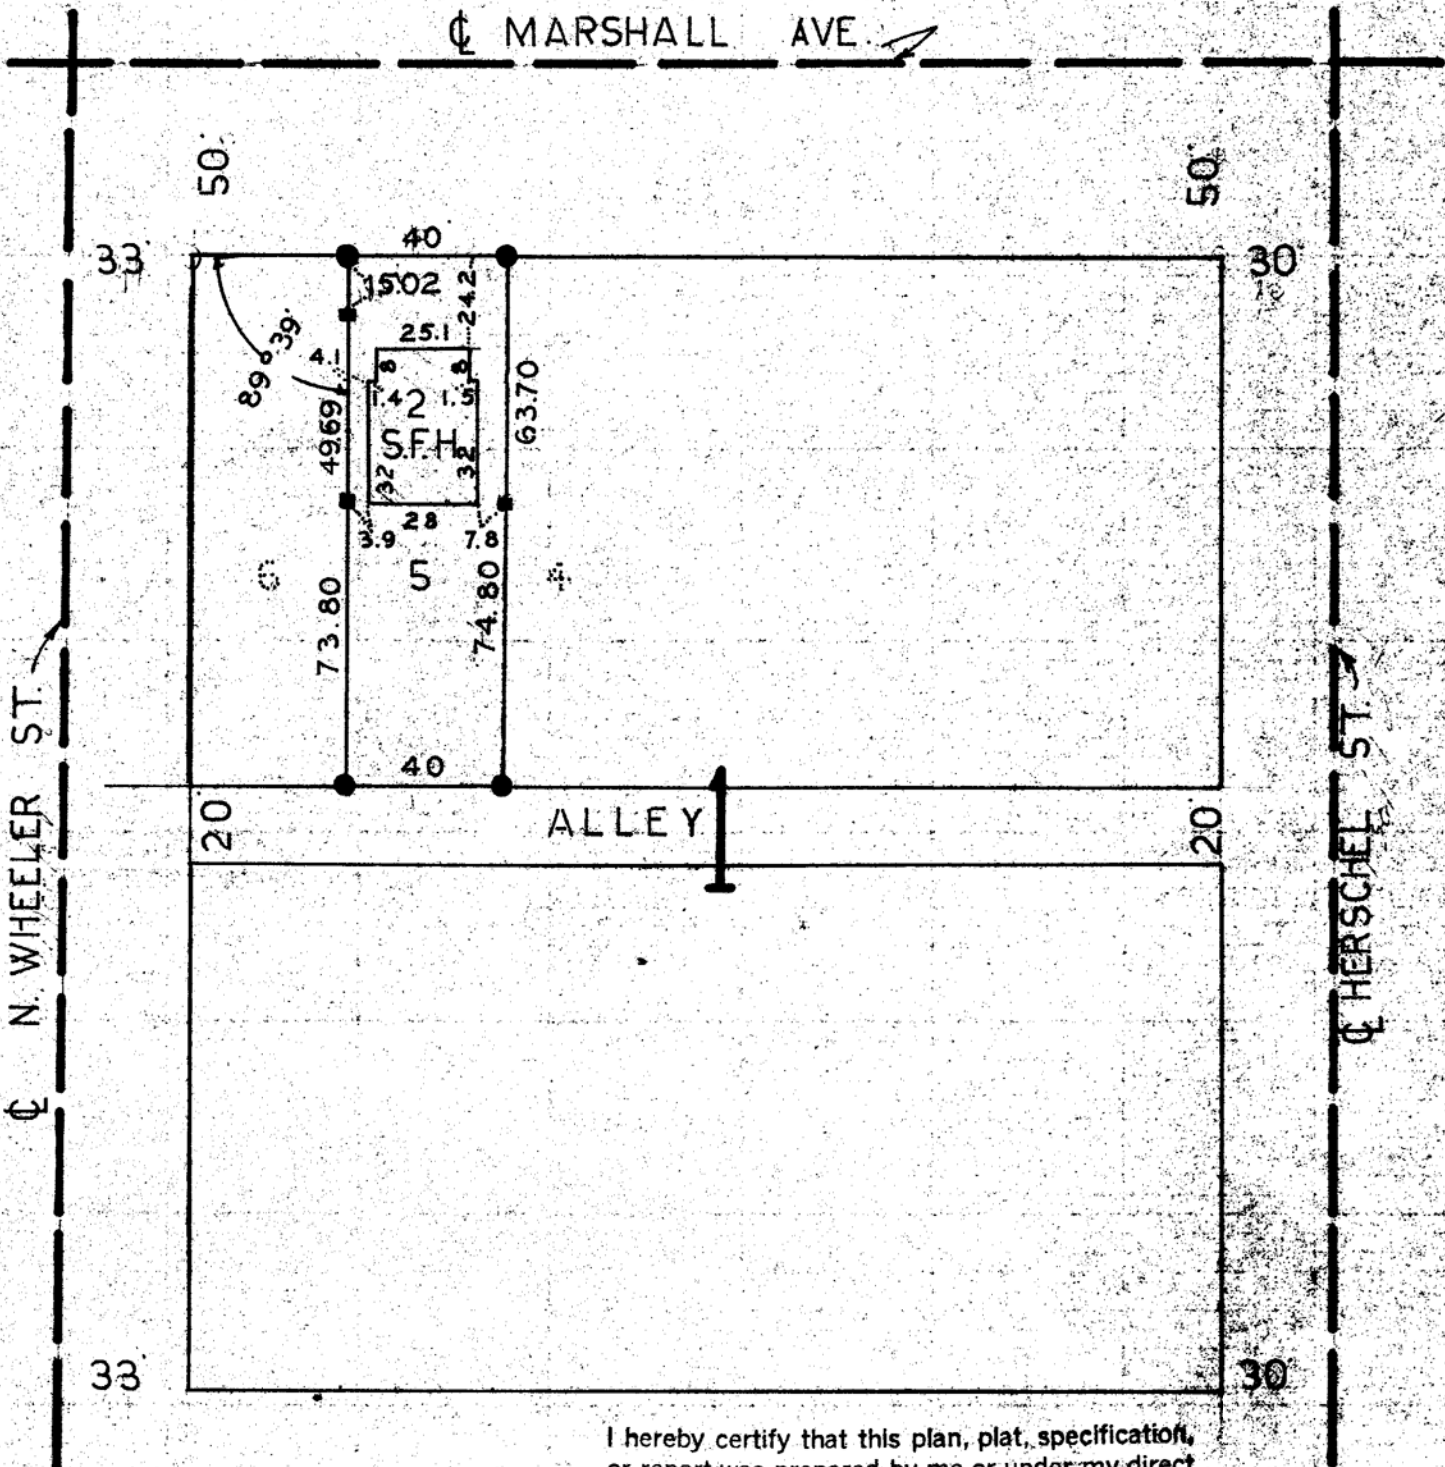

I hereby certify that this plan, plat, specification, or report was prepared by me or under my direct supervision and that I am a duly Registered Professional Engineer and Land Surveyor under the laws of the State of Minnesota.

*William Hunt*

Date SEP 18 1965 Reg. No. 1538



N

SCALE: 1" = 50'