PLAT OF SURVEY

OF PROPERTY OF JUAN J. COLON ET AL

DESCRIBED AS FOLLOWS WALCOTTS ADDITION

EXCEPT THE SOUTH 33 FEET FOR STREET THE PART SOUTHERLY OF NORTHERN

PACIFIC RAILROAD RIGHT OF WAY OF LOTS 10 & 11 CITY OF ST. PAUL, MINNESOTA

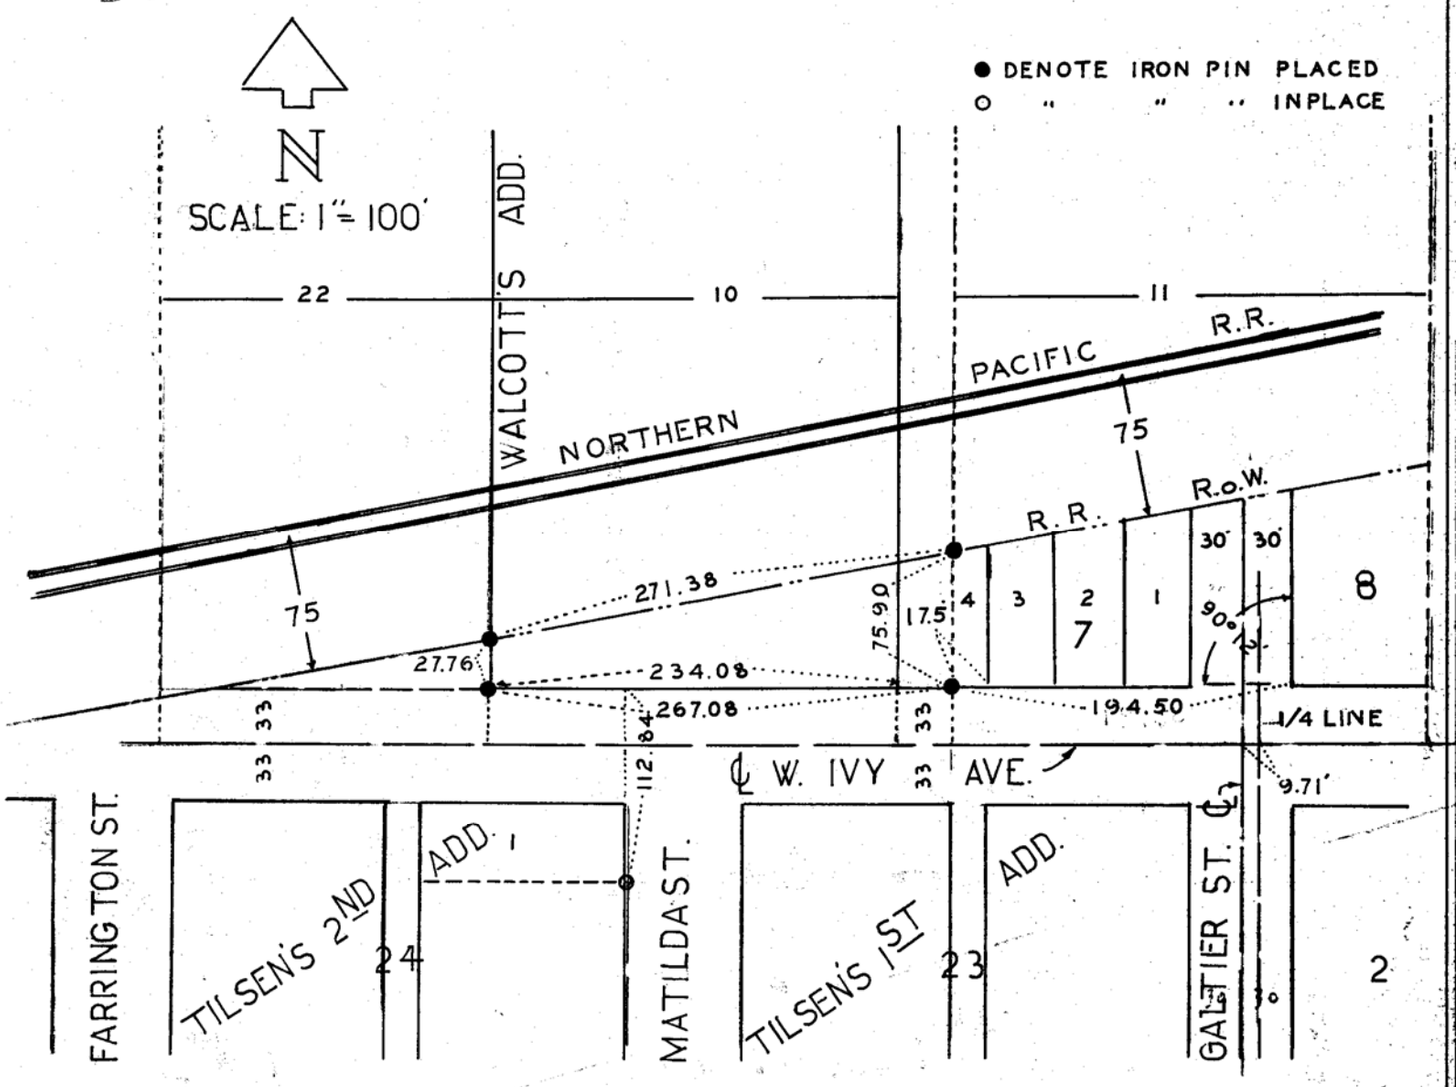

I hereby certify that this plan, plat, specification, or report was prepared by me or under my direct supervision and that I am a duly Registered Professional Engineer and Land Surveyor under the laws of the State of Minnesota.

P. E. Stig Rum

Date 4-19-65 Reg. No. 1538