


PLAT OF SURVEY

OF PROPERTY OF: EUGENE A. BARRINGER (746 AURORA AVENUE)

DESCRIBED AS FOLLOWS LOT 10 BLOCK 5 BUTTERFIELD SYNDICATE

ADDITION NUMBER 1 TO THE CITY OF ST. PAUL, RAMSEY COUNTY MINNESOTA

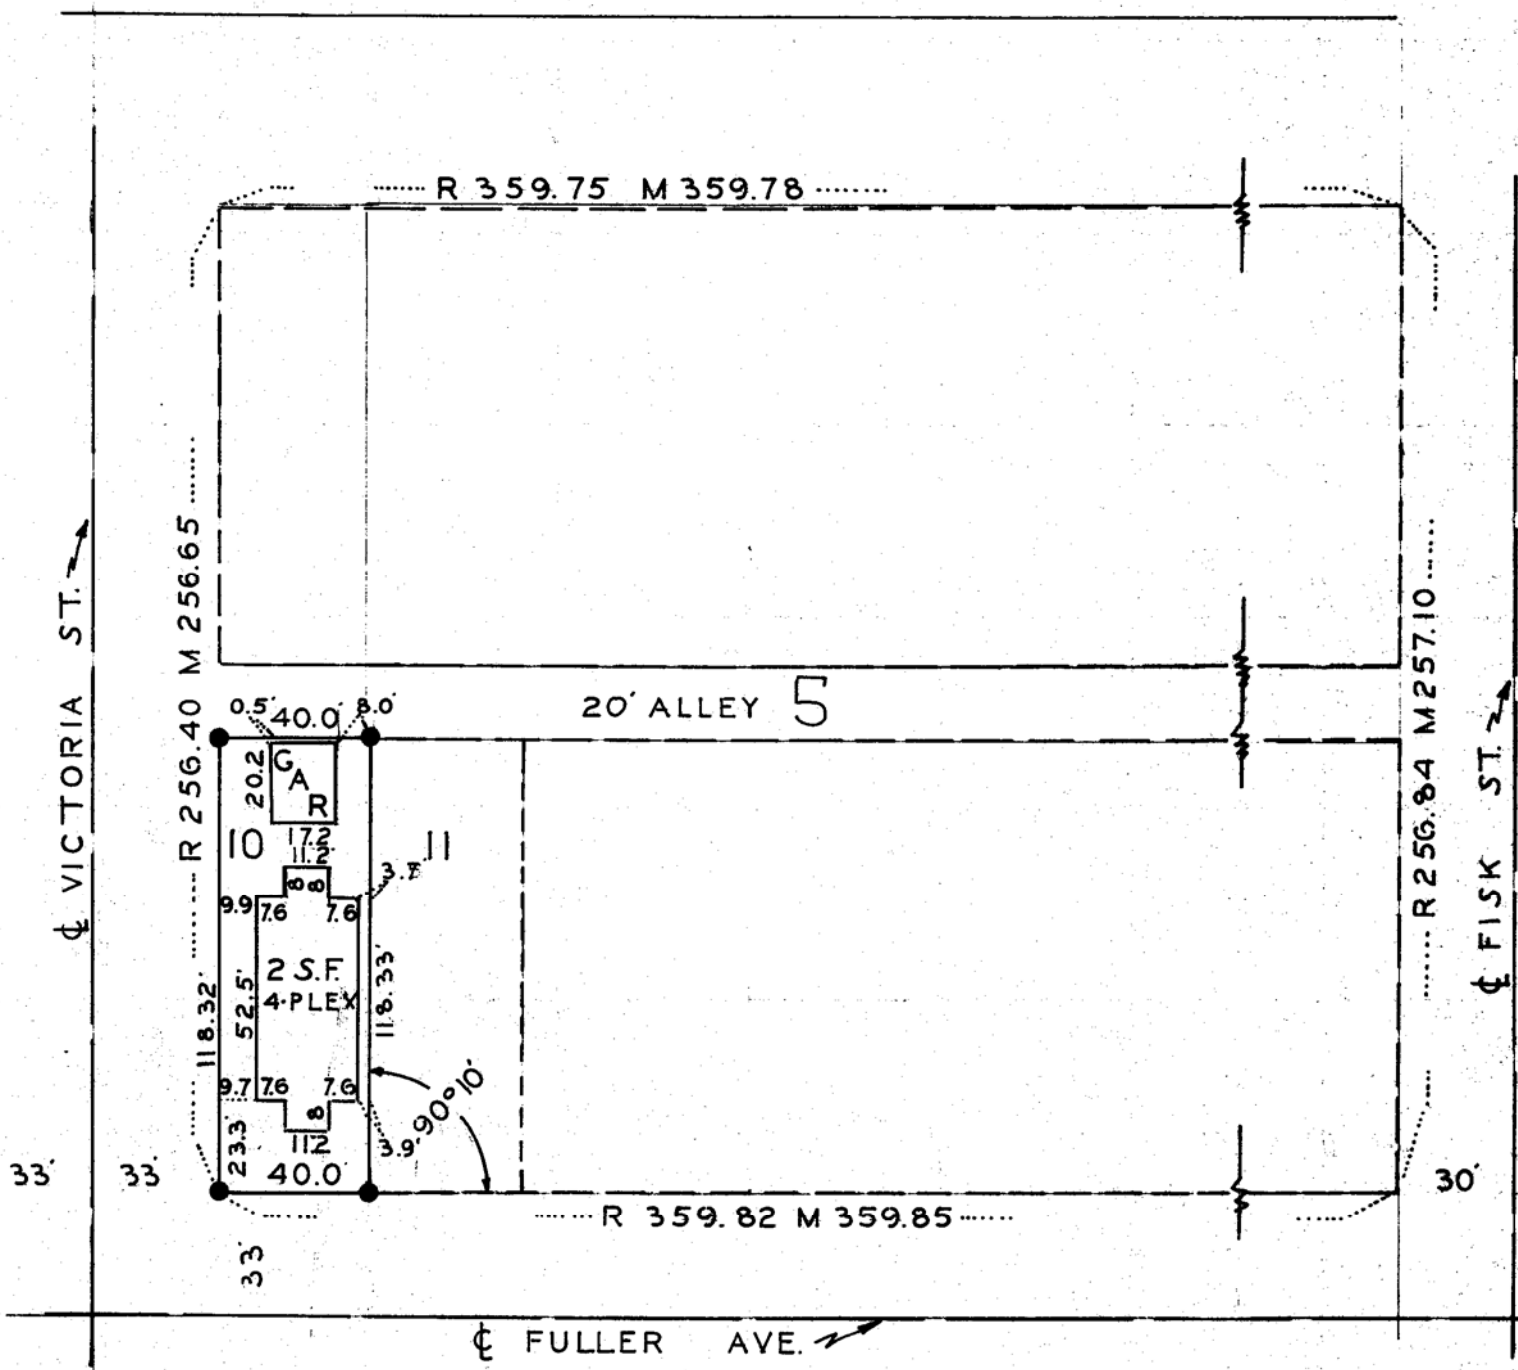

● DENOTES IRON PIN
 R=RECORDED MEAS'T.
 M=FIELD MEAS'T.



SCALE: 1"=50'

P. E. Highum
 Land Surveyor
 1275 St. Paul Avenue
 St. Paul, Minn. - 55116

I hereby certify that this plan, plat, specification or report was prepared by me or under my direct supervision and that I am a duly Registered Professional Engineer and Land Surveyor under the laws of the State of Minnesota.

P. E. Highum

Date MAY 31, 1965 Reg. No. 1538