PLAT OF SURVEY

OF PROPERTY OF: O.L. FINLEY

DESCRIBED AS FOLLOWS: LOT 31 BLOCK 2

KIPPS GLEN TERRACE ADDITION TO THE CITY OF ST. PAUL, RAMSEY COUNTY, MINNESOTA

● IRON PIN PLACED
o 60-D SPIKE PLACED
M-MEASURED
R-RECORD

N

SCALE: 1"=50'

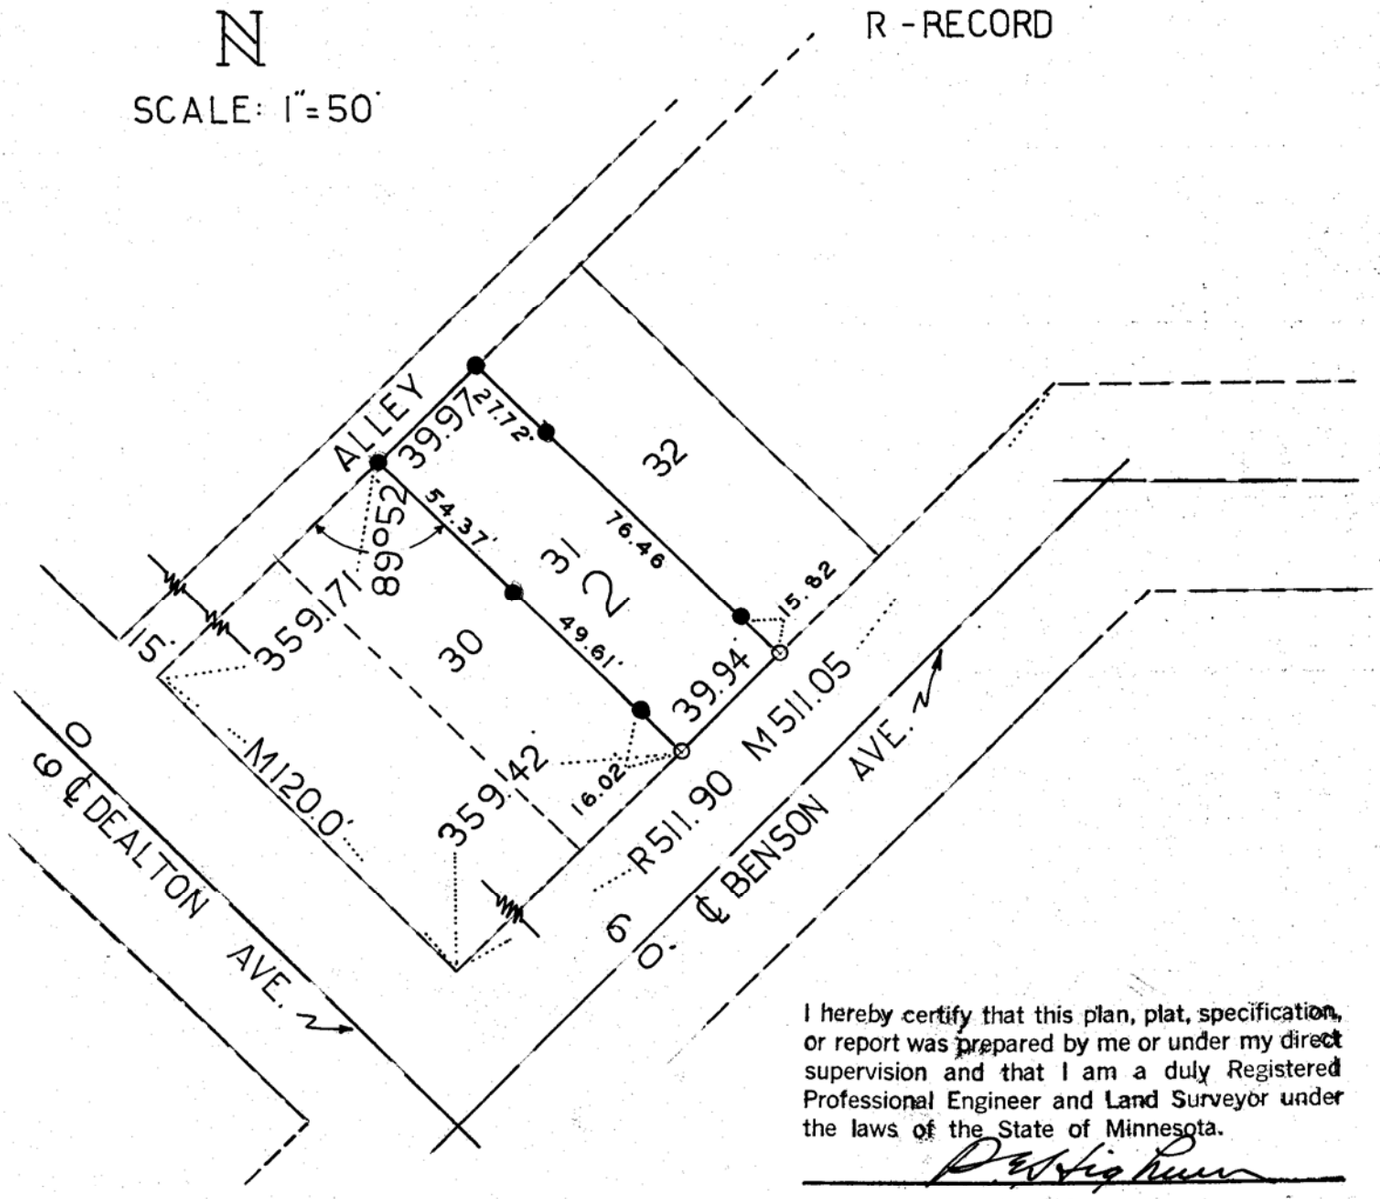

I hereby certify that this plan, plat, specification, or report was prepared by me or under my direct supervision and that I am a duly Registered Professional Engineer and Land Surveyor under the laws of the State of Minnesota.

Date 5-17-65 Reg. No. 1538