PLAT OF SURVEY

OF PROPERTY OF: ESTHER C. BERG FINN

DESCRIBED AS FOLLOWS: LOT 32 BLOCK 2

KIPPS GLEN TERRACE ADDITION TO THE CITY OF ST. PAUL, RAMSEY COUNTY, MINNESOTA

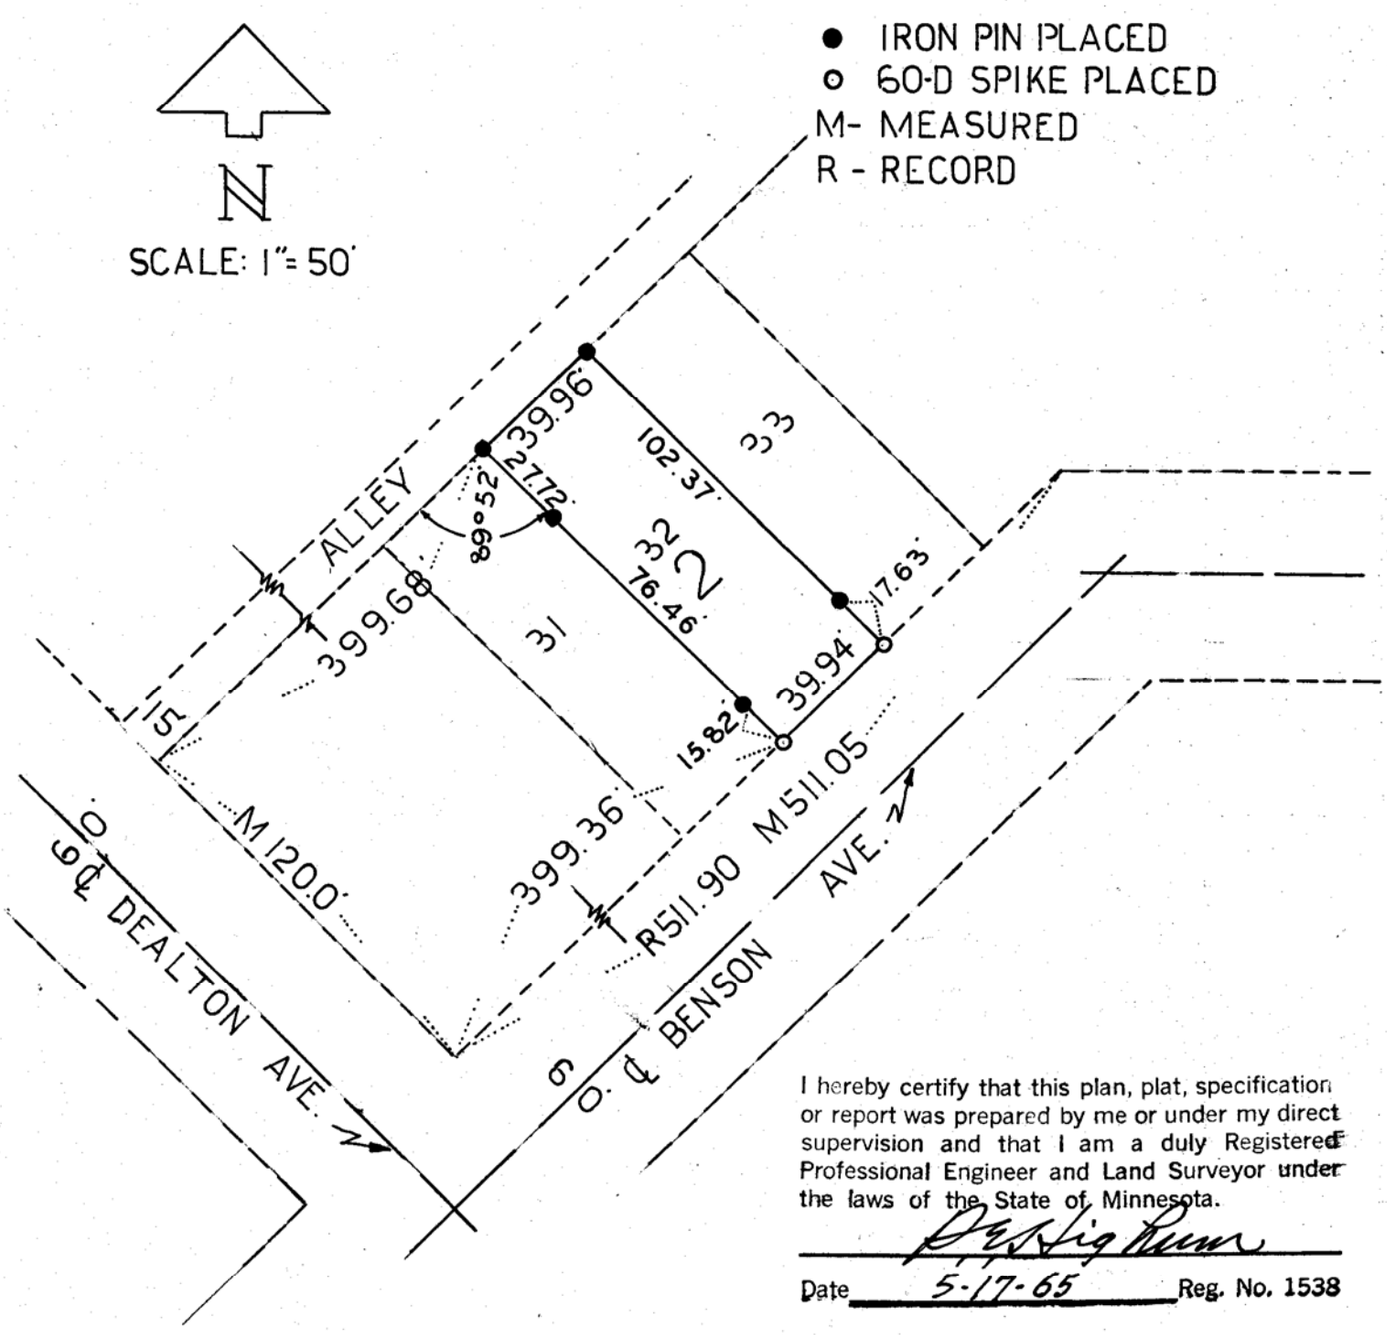

I hereby certify that this plan, plat, specification or report was prepared by me or under my direct supervision and that I am a duly Registered Professional Engineer and Land Surveyor under the laws of the State of Minnesota.

Date 5-17-65 Reg. No. 1538