PLAT OF SURVEY

OF PROPERTY OF: WALTER EDWORTHY (1366 LAFOND AVENUE)

DESCRIBED AS FOLLOWS: LOT 7 BLOCK 14 SYNDICATE ADDITION # 5

CITY OF ST. PAUL, RAMSEY COUNTY, MINNESOTA

N

● DENOTES IRON PIN PLACED

▫ DENOTES CONCRETE MONUMENT INPLACE

R INDICATES RECORD DISTANCE

M INDICATES MEASURED DISTANCE

SCALE: 1" = 50'

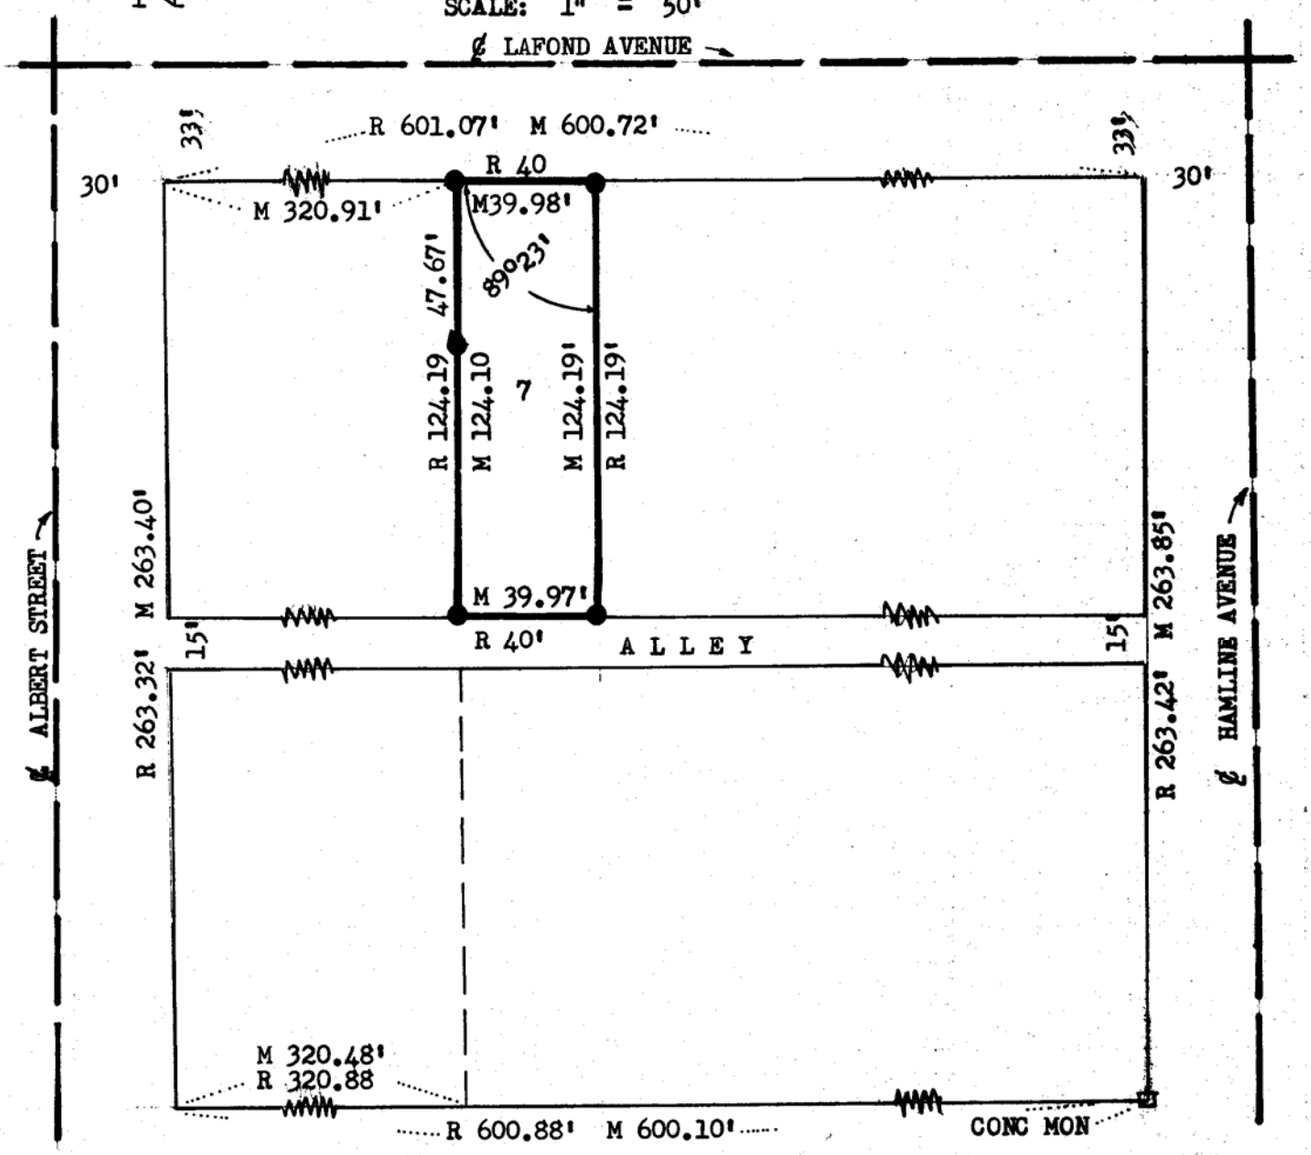

I hereby certify that this plan, plat, specification, or report was prepared by me or under my direct supervision and that I am a duly Registered Professional Engineer and Land Surveyor under the laws of the State of Minnesota.

P. E. Bigham

Date AUG 1 9 1965 Reg. No. 1538