PLAT OF SURVEY

OF PROPERTY OF: PAUL AND LUCILLE BABLER (915 WELLS)

DESCRIBED AS FOLLOWS: LOTS 32-33 & 34 BLOCK 6

Chas. Weide's Rearr. BLOCK 6 NELSON ADDITION

CITY OF ST. PAUL

RAMSEY COUNTY MINNESOTA

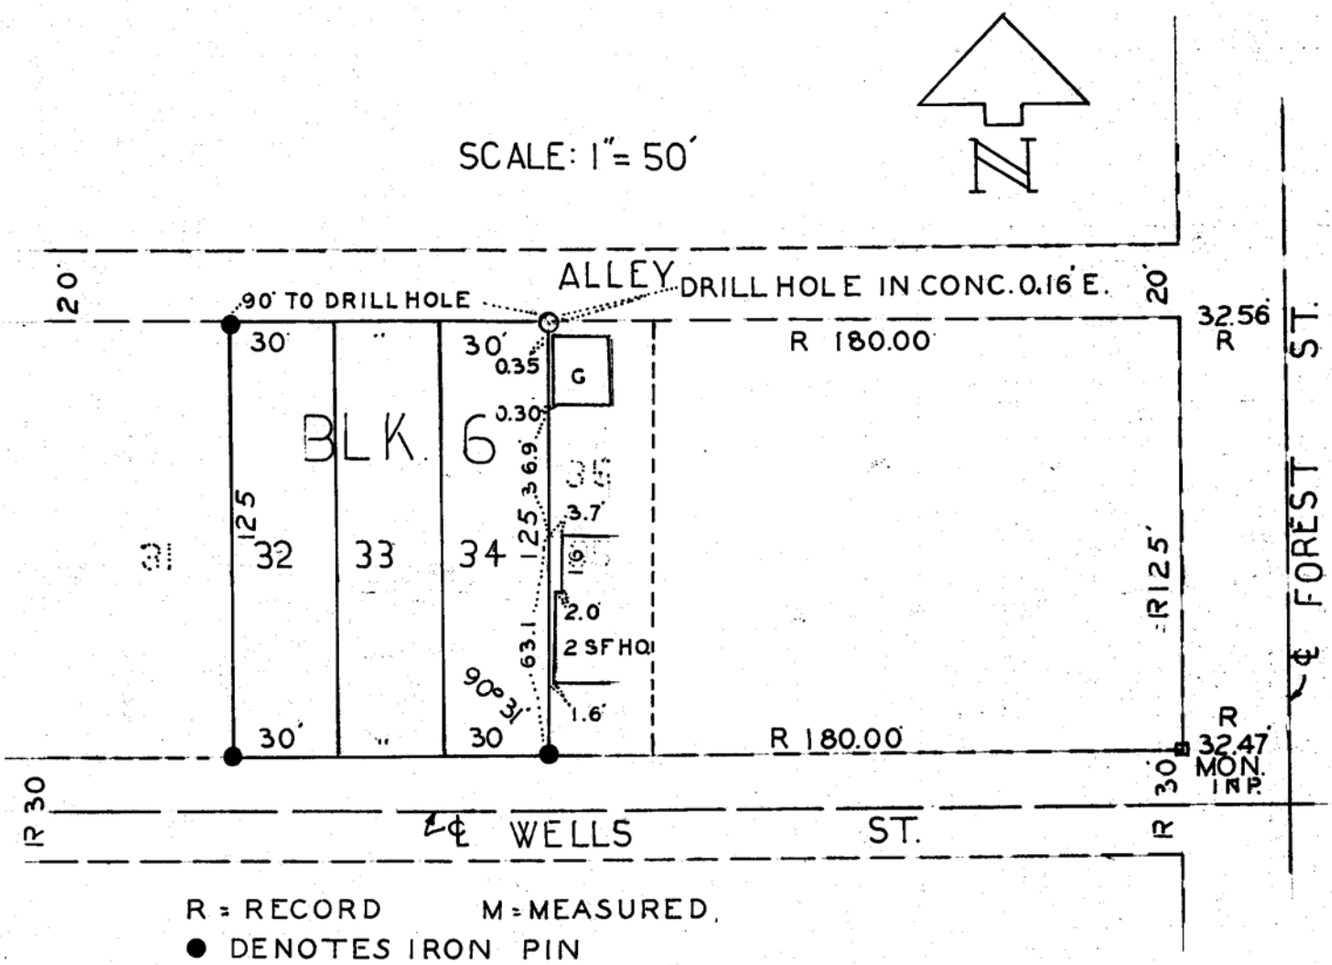

R = RECORD M = MEASURED

● DENOTES IRON PIN

○ DENOTE IRON PIN INPLACE

I hereby certify that this plan, plat, specification, or report was prepared by me or under my direct supervision and that I am a duly Registered Professional Engineer and Land Surveyor under the laws of the State of Minnesota.

Date JUL 26 1965 Reg. No. 1538