
PLAT OF SURVEY

OF PROPERTY OF: EDWARD ALTENDORFER


DESCRIBED AS FOLLOWS ALL OF LOT 8 AND THE EAST ONEHALF OF LOT 9 BLOCK 34, THE WEST ST. PAUL REAL ESTATE AND

IMPROVEMENT SYNDICATE ADDITION NO. 2 -- ST. PAUL, RAMSEY

COUNTY, MINNESOTA

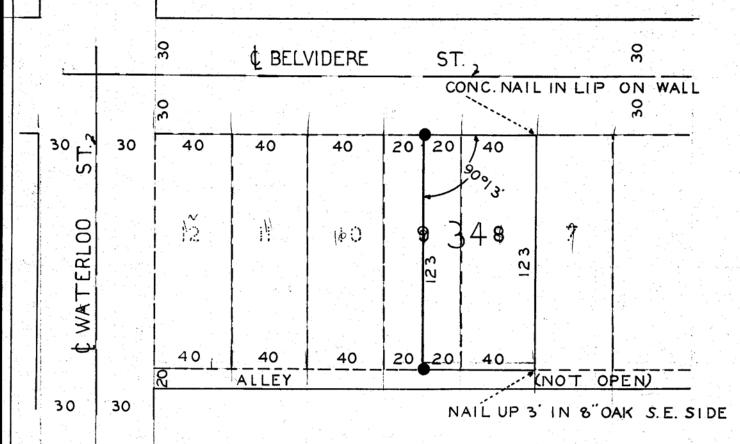

DENOTES IRON PIN

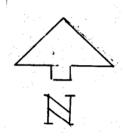

SCALE: 1"-50

I hereby certify that this plan, plat, specification, or report was prepared by me or under my direct supervision and that I am a duly Registered Professional Engineer and Land Surveyor under the laws of the State of Minnesota.

- Fishing Trum

Date______ **JUL** 2 8 1965

Reg. No. 1538

JUL 28 1965