NW 5 29 23

Certificate of Survey

FROM THE OFFICE OF

CHARLES O. GEORGI COMPANY

2215 West County Road B — Saint Paul 13, Minnesota

REGISTERED CIVIL ENGINEER AND LAND SURVEYOR

I Hereby Certify that this plat shows a survey made by me of the property described on this plat, and that the corners are correctly placed as shown, and that all locations have been correctly shown.

Surveyed For Stuart Oil Co

Date January 1965

Scale 1" = 50'

By Charles O. Georgi
REGISTERED LAND SURVEYOR

Description:

That part of the NW¼ of Section 5, T29N, R23W, described as follows; Commencing at a point in the South line of said NW¼ distant 330 feet East of the Southwest corner of said NW¼; thence Northeasterly forming an angle of 51° 26' with the South line of said NW¼ a distance of 177.8 feet; thence West parallel with the South line of said NW¼ 337.8 feet more or less to the center line of State Highway No. 63; thence Southwesterly along said center line of State Highway 152.6 feet more or less, to the South line of said NW¼; thence East 290 feet more or less to the point of beginning, subject to County Road C-2 and except State Highway Right-of-Way.
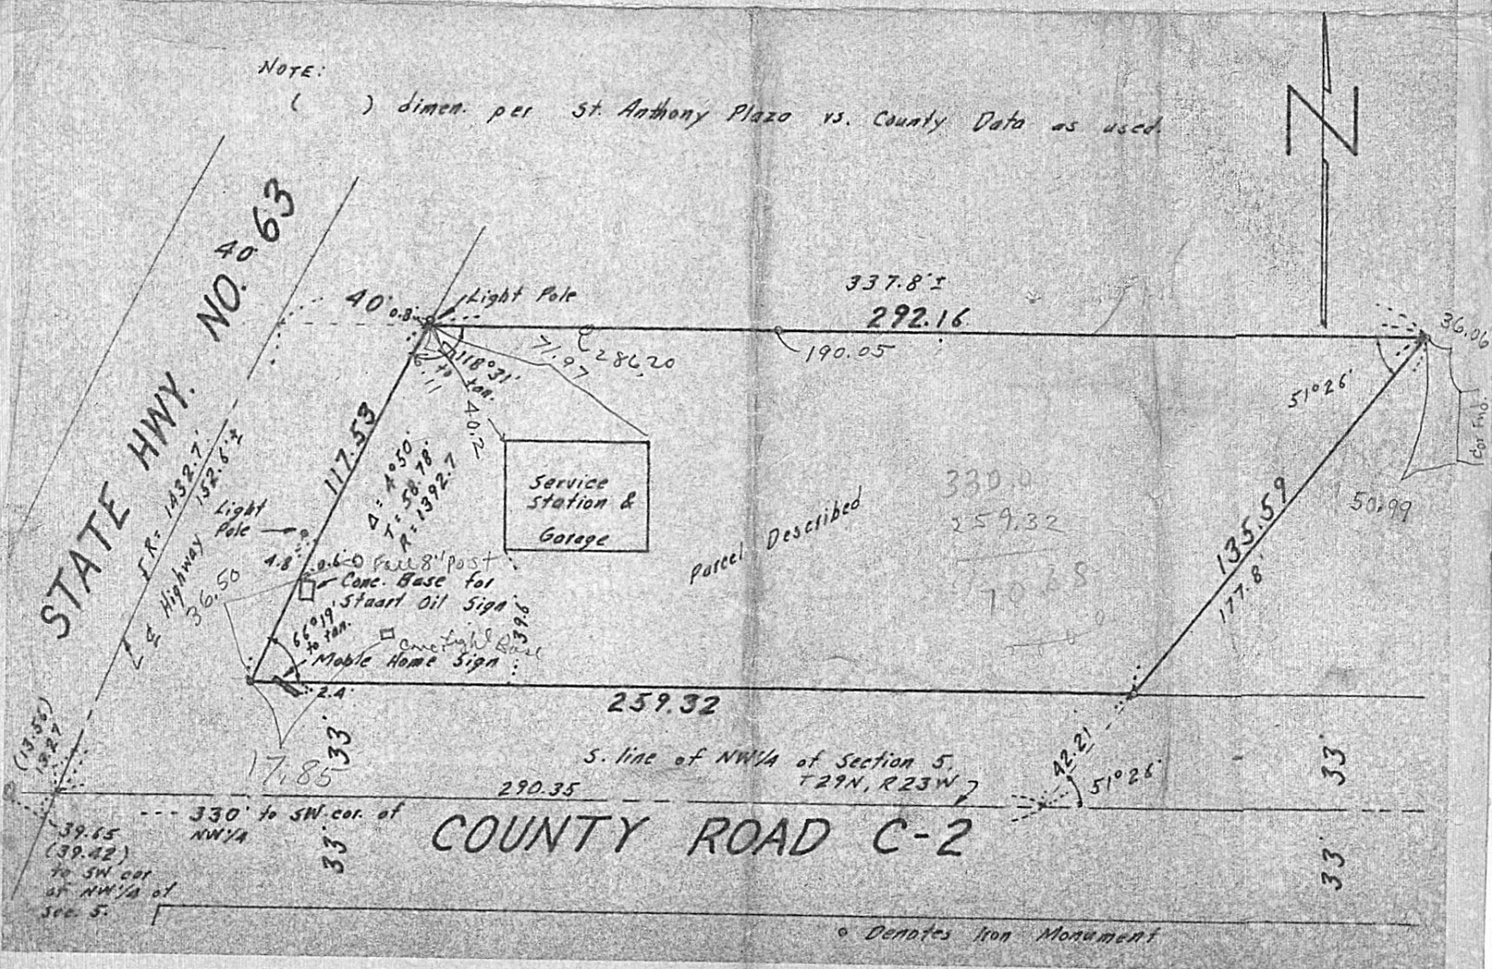
NOTE:
( ) dimen. per St. Anthony Plaza vs. County Data as used.