FROM THE OFFICE OF SE - 11 30 23

CHARLES O. GEORGI COMPANY

2215 West County Road B Saint Paul 13, Minnesota

REGISTERED CIVIL ENGINEER AND LAND SURVEYOR

Certificate of Survey

I Hereby Certify that this plat shows a survey made by me of the property described on this plat, and that the corners are correctly placed as shown, and that all locations have been correctly shown.

Surveyed For Ralph Bohr

Date March 1965

Scale 1" = 100'

By [signature]
REGISTERED LAND SURVEYOR

Description:
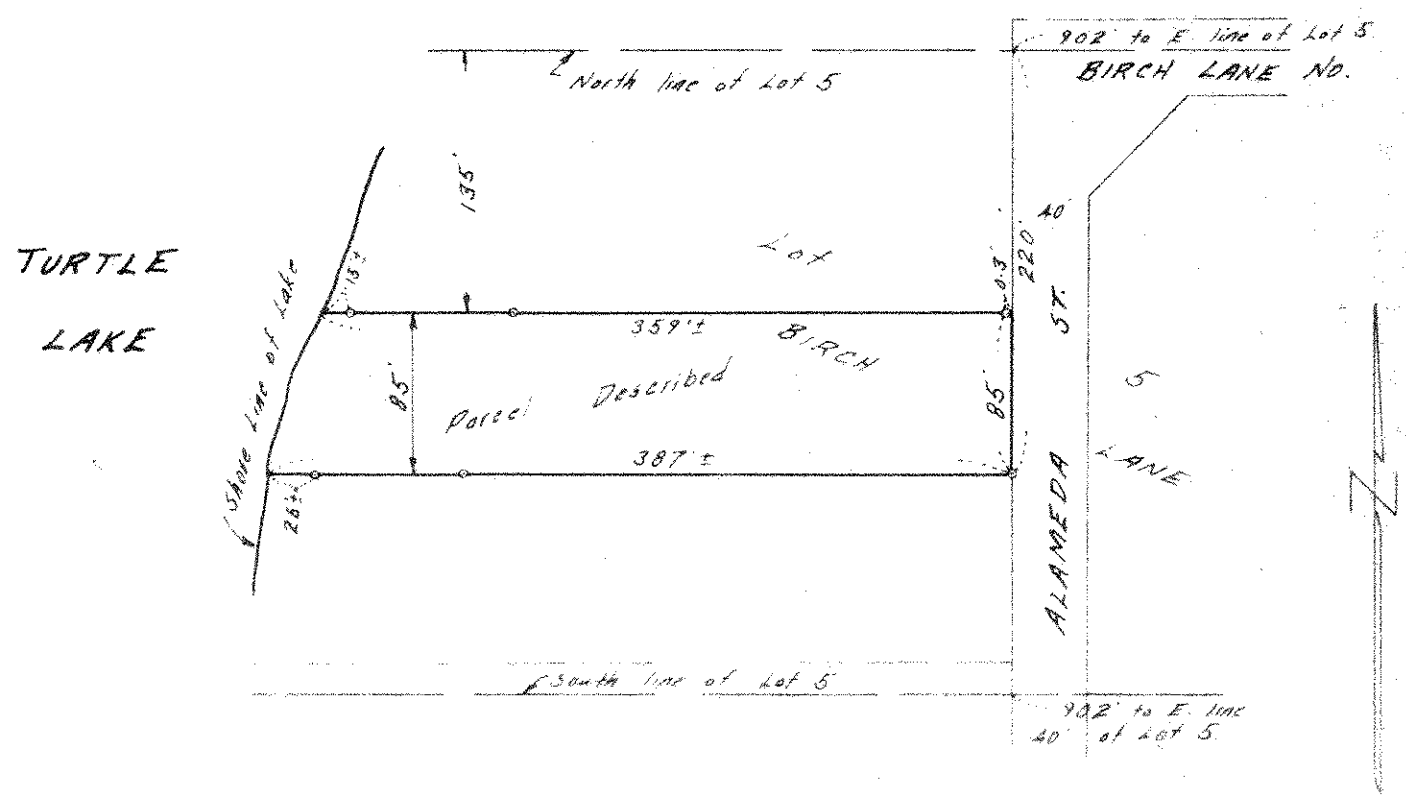
The South 85 feet of the North 220 feet of Lot 5, Birch Lane except the East 902 feet thereof.