E½ 28 30 22

FROM THE OFFICE OF

CHARLES O. GEORGI COMPANY

2215 West County Road B Saint Paul, Minnesota 55113

REGISTERED CIVIL ENGINEER AND LAND SURVEYOR

Certificate of Survey

I Hereby Certify that this plat shows a survey made by me of the property described on this plat, and that the corners are correctly placed as shown, and that all locations have been correctly shown.

Surveyed For John J. Kenna

Date Dec. 1965

Scale 1" = 200'

By Charles O. Georgi
REGISTERED LAND SURVEYOR

Description:

The East 364 feet of Lot 15, Stockdale Farms, Ramsey County, Minnesota, according to the plat thereof filed of record in the office of the Registrar of Titles within and for said County;

Also the East 364 feet of the North 101 feet of the West ½ of the North ½ of the North ½ of the SE¼ of Section 28, T30N, R22W.
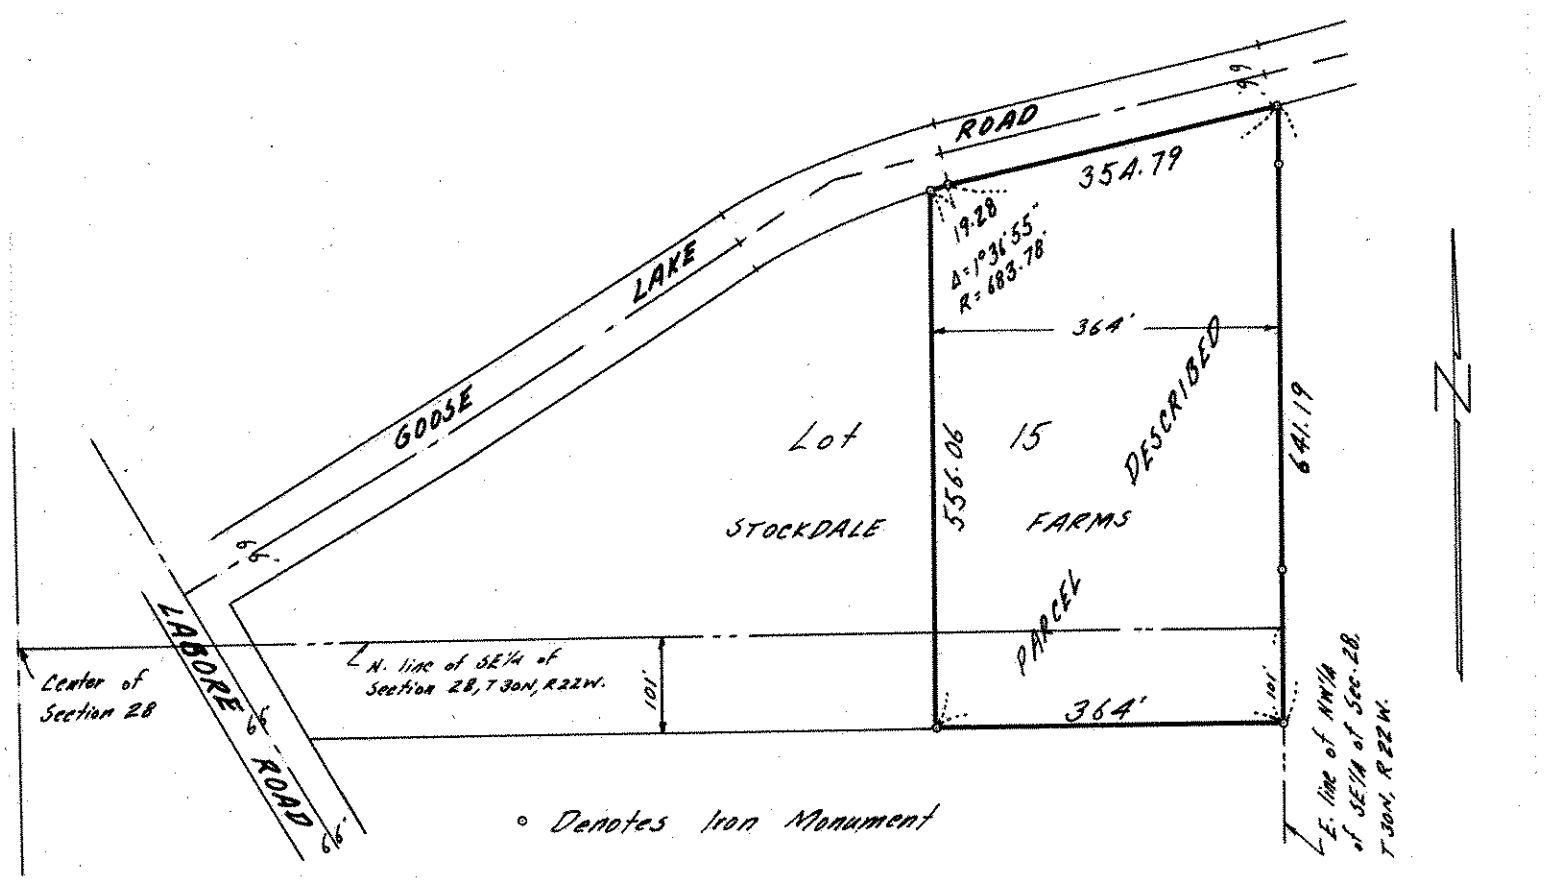
Containing 5.00 Acres more or less.