

NE 23 29 22

FROM THE OFFICE OF

# CHARLES O. GEORGI COMPANY

2215 West County Road B Saint Paul 13, Minnesota  
REGISTERED CIVIL ENGINEER AND LAND SURVEYOR

## Certificate of Survey


I Hereby Certify that this plat shows a survey made by me of the property described on this plat, and that the corners are correctly placed as shown, and that all locations have been correctly shown.

Surveyed For Leon A. Ross  
Date Nov. 1965  
Scale 1" = 100'

Description: Summer 1985 located irons. By CWS REGISTERED LAND SURVEYOR #10459

The West 60 feet of Lot 3, Block 8, Furness' Garden Lots

The West 84 feet of Lot 9, Block 8, Furness' Garden Lots

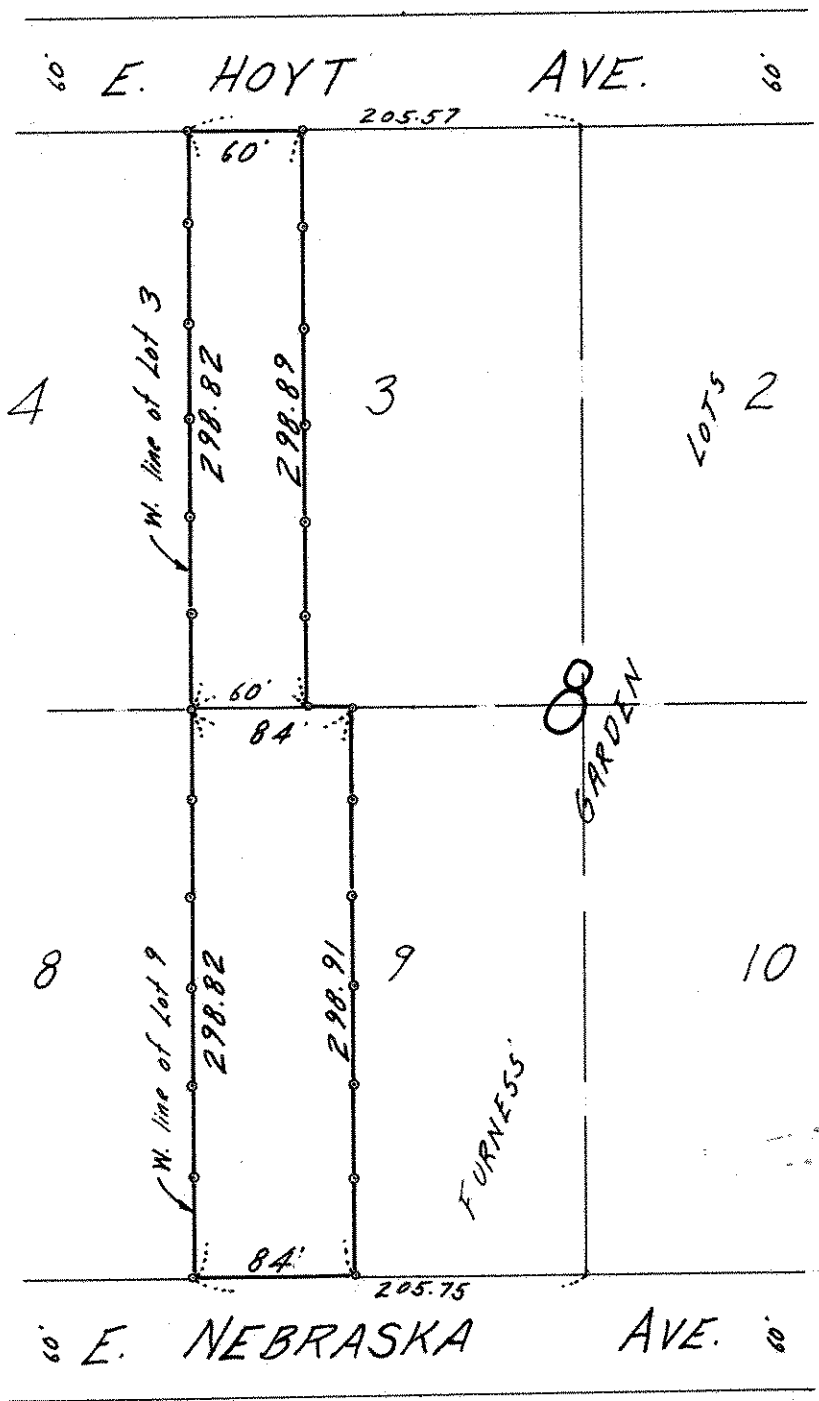

o Denotes Iron Monument