

FROM THE OFFICE OF

CHARLES O. GEORGI COMPANY

2215 West County Road B

Saint Paul 13, Minnesota

REGISTERED CIVIL ENGINEER AND LAND SURVEYOR



Certificate of Survey

I Hereby Certify that this plat shows a survey made by me of the property described on this plat, and that the corners are correctly placed as shown, and that all locations have been correctly shown.

Surveyed For Boston - St. Paul College Club

Date June 1965


Scale 1" = 50'

By Charles O. Georgi
REGISTERED LAND SURVEYOR

Description:

The West 30 feet of lot 3 and all of lots 4 and 5, Block 34, Summit Park Addition

Centerline of Summit 7

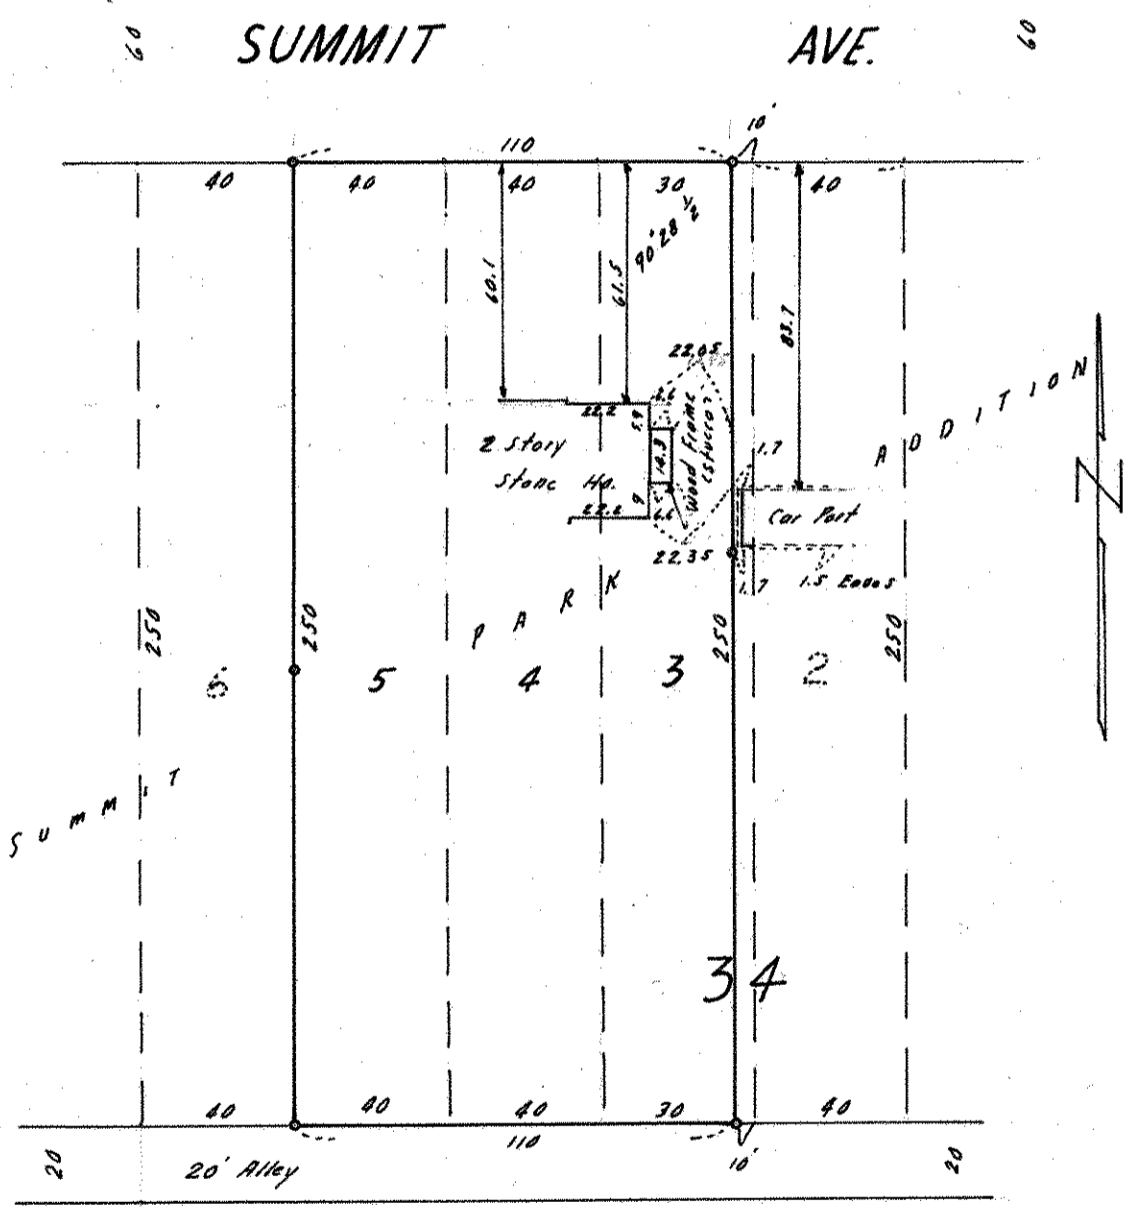

• Denotes Iron Monument