NE 35 30 22

FROM THE OFFICE OF

CHARLES O. GEORGI COMPANY

2215 West County Road B Saint Paul, Minnesota 55113

REGISTERED CIVIL ENGINEER AND LAND SURVEYOR

Certificate of Survey

I Hereby Certify that this plat shows a survey made by me of the property described on this plat, and that the corners are correctly placed as shown, and that all locations have been correctly shown.

Surveyed For WHITE BEAR LAKE AREA PUBLIC SCHOOLS

Date October 1966

Scale 1" = 100'

By Charles O. Georgi
REGISTERED LAND SURVEYOR

Description: (Retained by owner)
The North 263 feet of the North 10 Acres of the East 60 Acres of the NE 1/4 of Section 35, T30N, R22W except the West 632 feet thereof and except the East 266.1 feet thereof, subject to County Road E. 266.10 wide — given wrong desc. (see other cut)

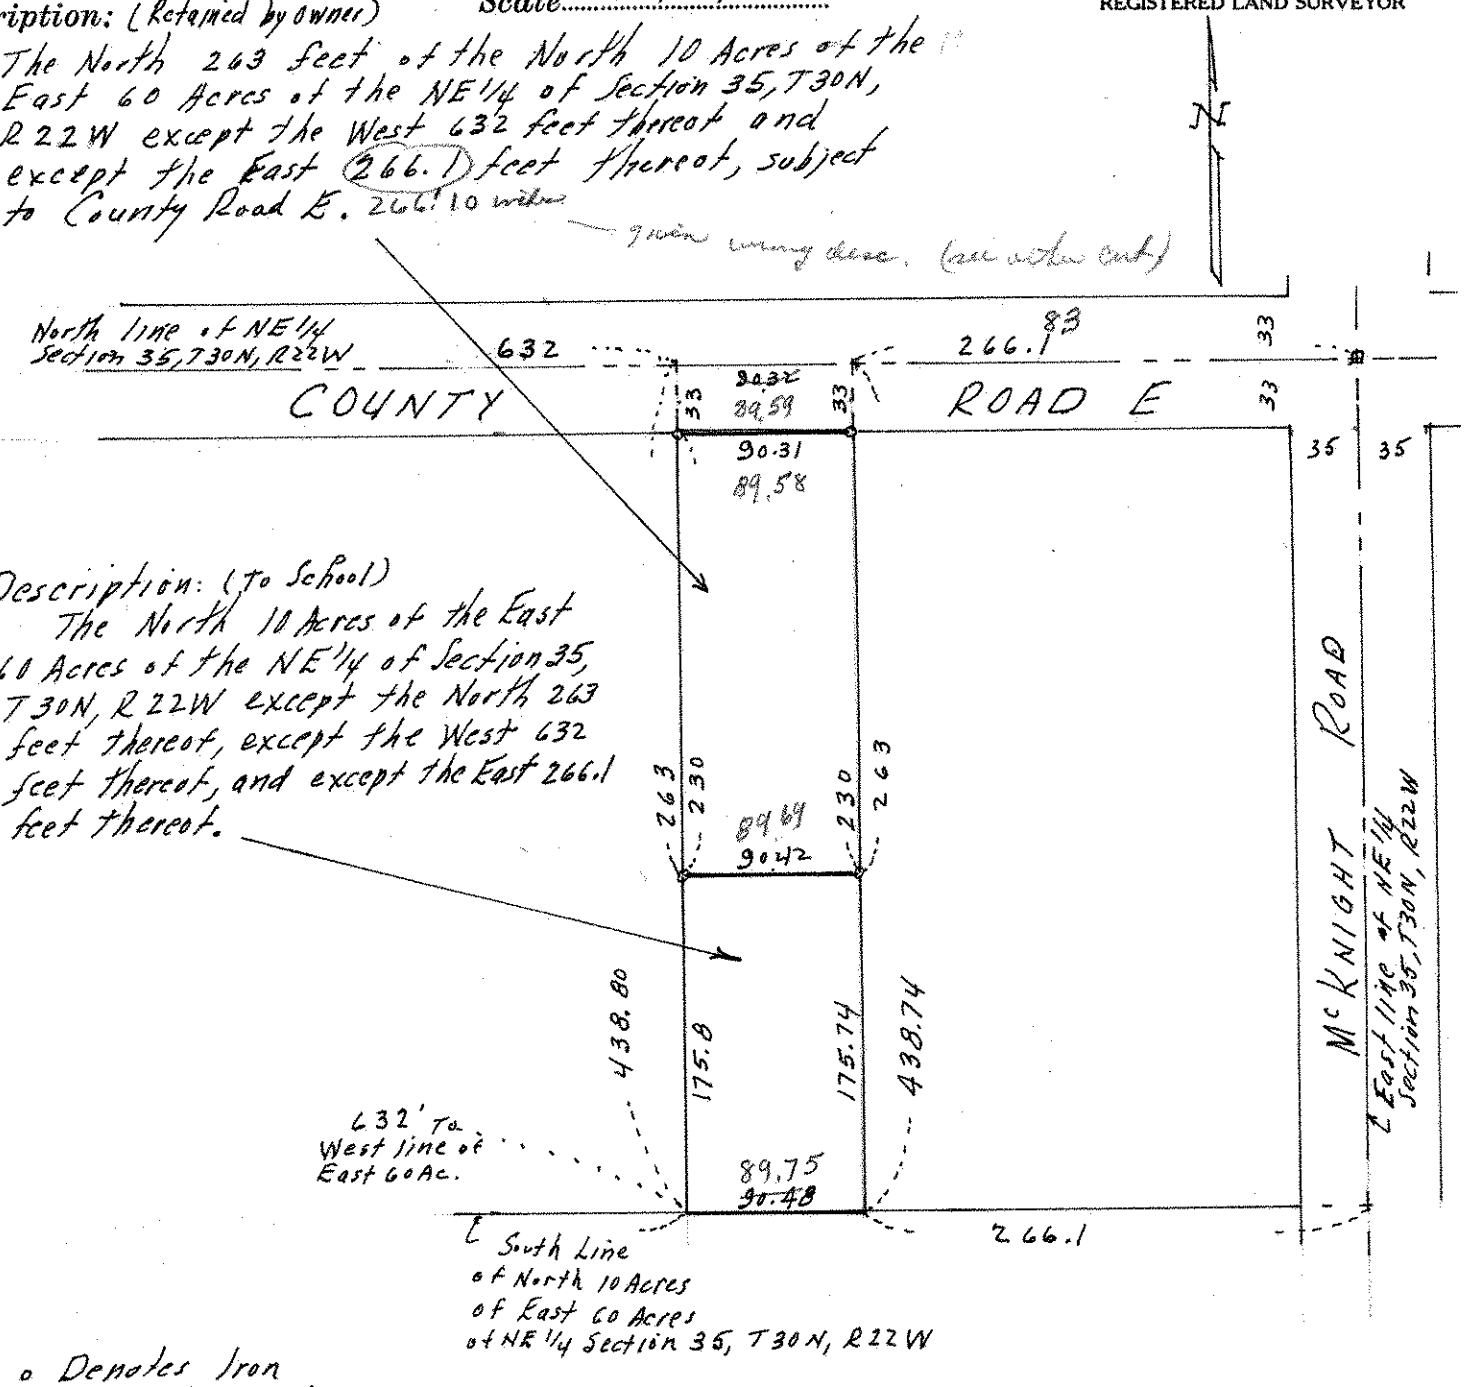

Description: (To School)
The North 10 Acres of the East 60 Acres of the NE 1/4 of Section 35, T30N, R22W except the North 263 feet thereof, except the West 632 feet thereof, and except the East 266.1 feet thereof.

o Denotes Iron Pipe Monument.
Acreage descriptions are in accord with U.S. Gov't Survey thereof.- Thus, shortage is prorated throughout.