NW 36 2923

FROM THE OFFICE OF

CHARLES O. GEORGI COMPANY

2215 West County Road B Saint Paul, Minnesota 55113

REGISTERED CIVIL ENGINEER AND LAND SURVEYOR

Certificate of Survey

I Hereby Certify that this plat shows a survey made by me of the property described on this plat, and that the corners are correctly placed as shown, and that all locations have been correctly shown. Encroachments are as shown. New fence extend South over lot line to house, and old leaning garage extends South over lot line.

Surveyed For Paul Raasch

Date March 1966

Scale 1" = 30'

By Charles O. Georgi
REGISTERED LAND SURVEYOR

Description:
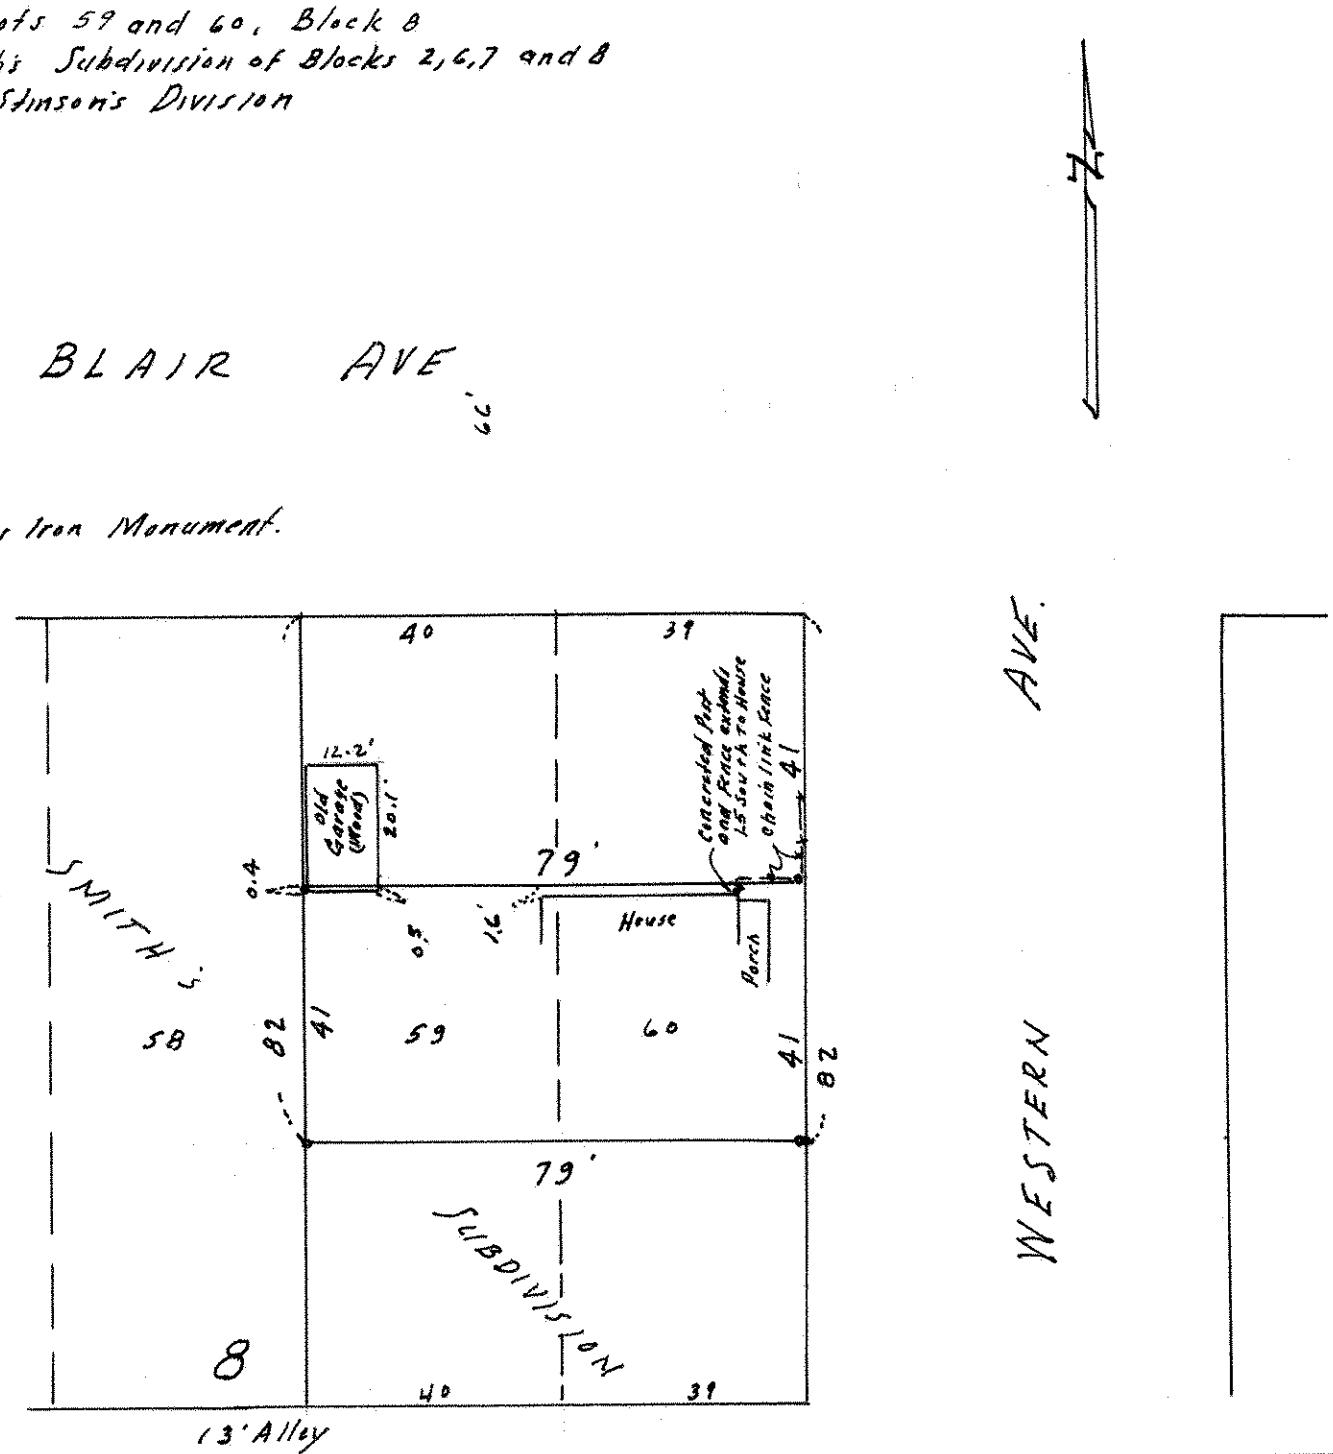
The South 41 feet of the North 82 feet of Lots 59 and 60, Block 8 Smith's Subdivision of Blocks 2, 6, 7 and 8 of Stinson's Division