NE / 2923

FROM THE OFFICE OF

CHARLES O. GEORGI COMPANY

2215 West County Road B Saint Paul, Minnesota 55113

REGISTERED CIVIL ENGINEER AND LAND SURVEYOR

Certificate of Survey

I Hereby Certify that this plat shows a survey made by me of the property described on this plat, and that the corners are correctly placed as shown, and that all locations have been correctly shown. 5/18/78 see note. C.O.G.

Surveyed For MAX L. BEERY

Date July 1966

Scale 1" = 50'

By Charles O. Georgi
REGISTERED LAND SURVEYOR

Description:

Lots 7 and 8
PLAINVIEW HEIGHTS
Ramsey County, MINN.

NOTE: Added house location on 2 August 1967.
Garage and Storage buildings in rear of lot not shown.
5/18/78 Relocated irons on lot 7; show garage in rear as lot 8 was sold.

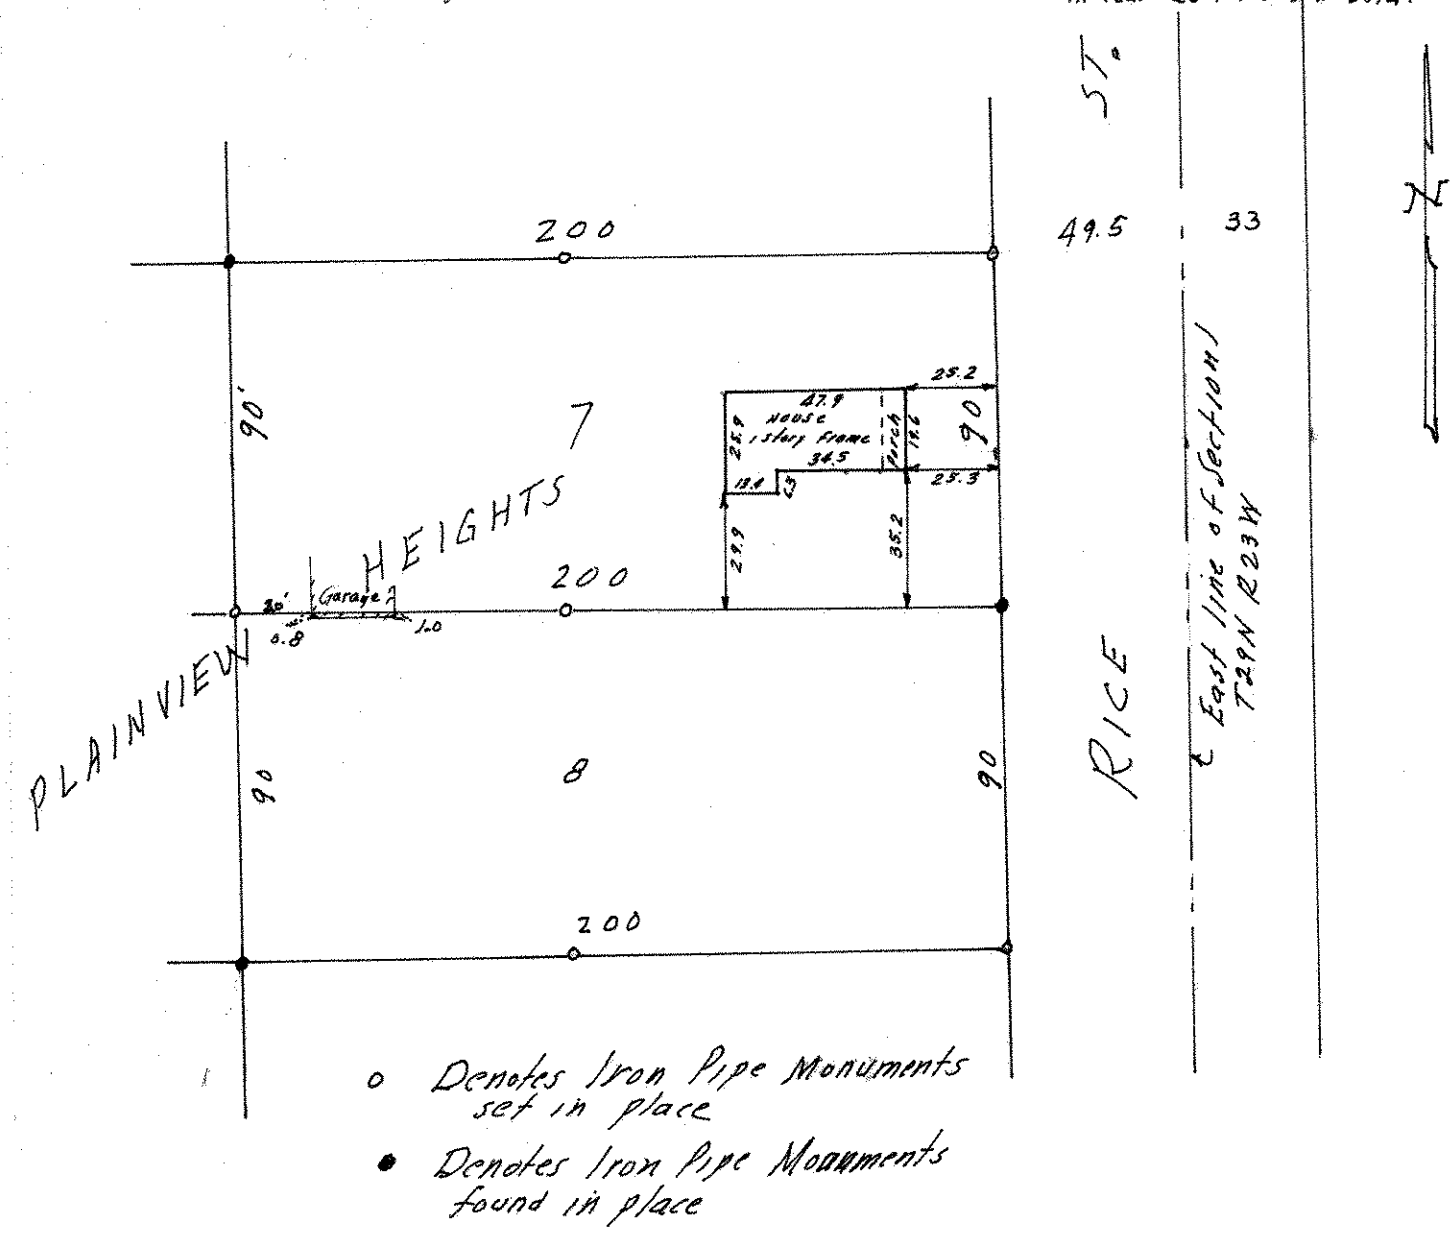

o Denotes Iron Pipe Monuments set in place

• Denotes Iron Pipe Monuments found in place