NW 27292

FROM THE OFFICE OF

# CHARLES O. GEORGI COMPANY

2215 West County Road B Saint Paul, Minnesota 55113

REGISTERED CIVIL ENGINEER AND LAND SURVEYOR

## Certificate of Survey

*I Hereby Certify that* this plat shows a survey made by me of the property described on this plat, and that the corners are correctly placed as shown, and that all locations have been correctly shown.

*Surveyed For* Roberts Const.

*Date* July 1966

*Scale* 1" = 50'

By Charles O. Georgi
REGISTERED LAND SURVEYOR

*Description:*

The North ½ of Lots 22 through 28
Block 1
Kiefer Park.
St Paul, Minn.
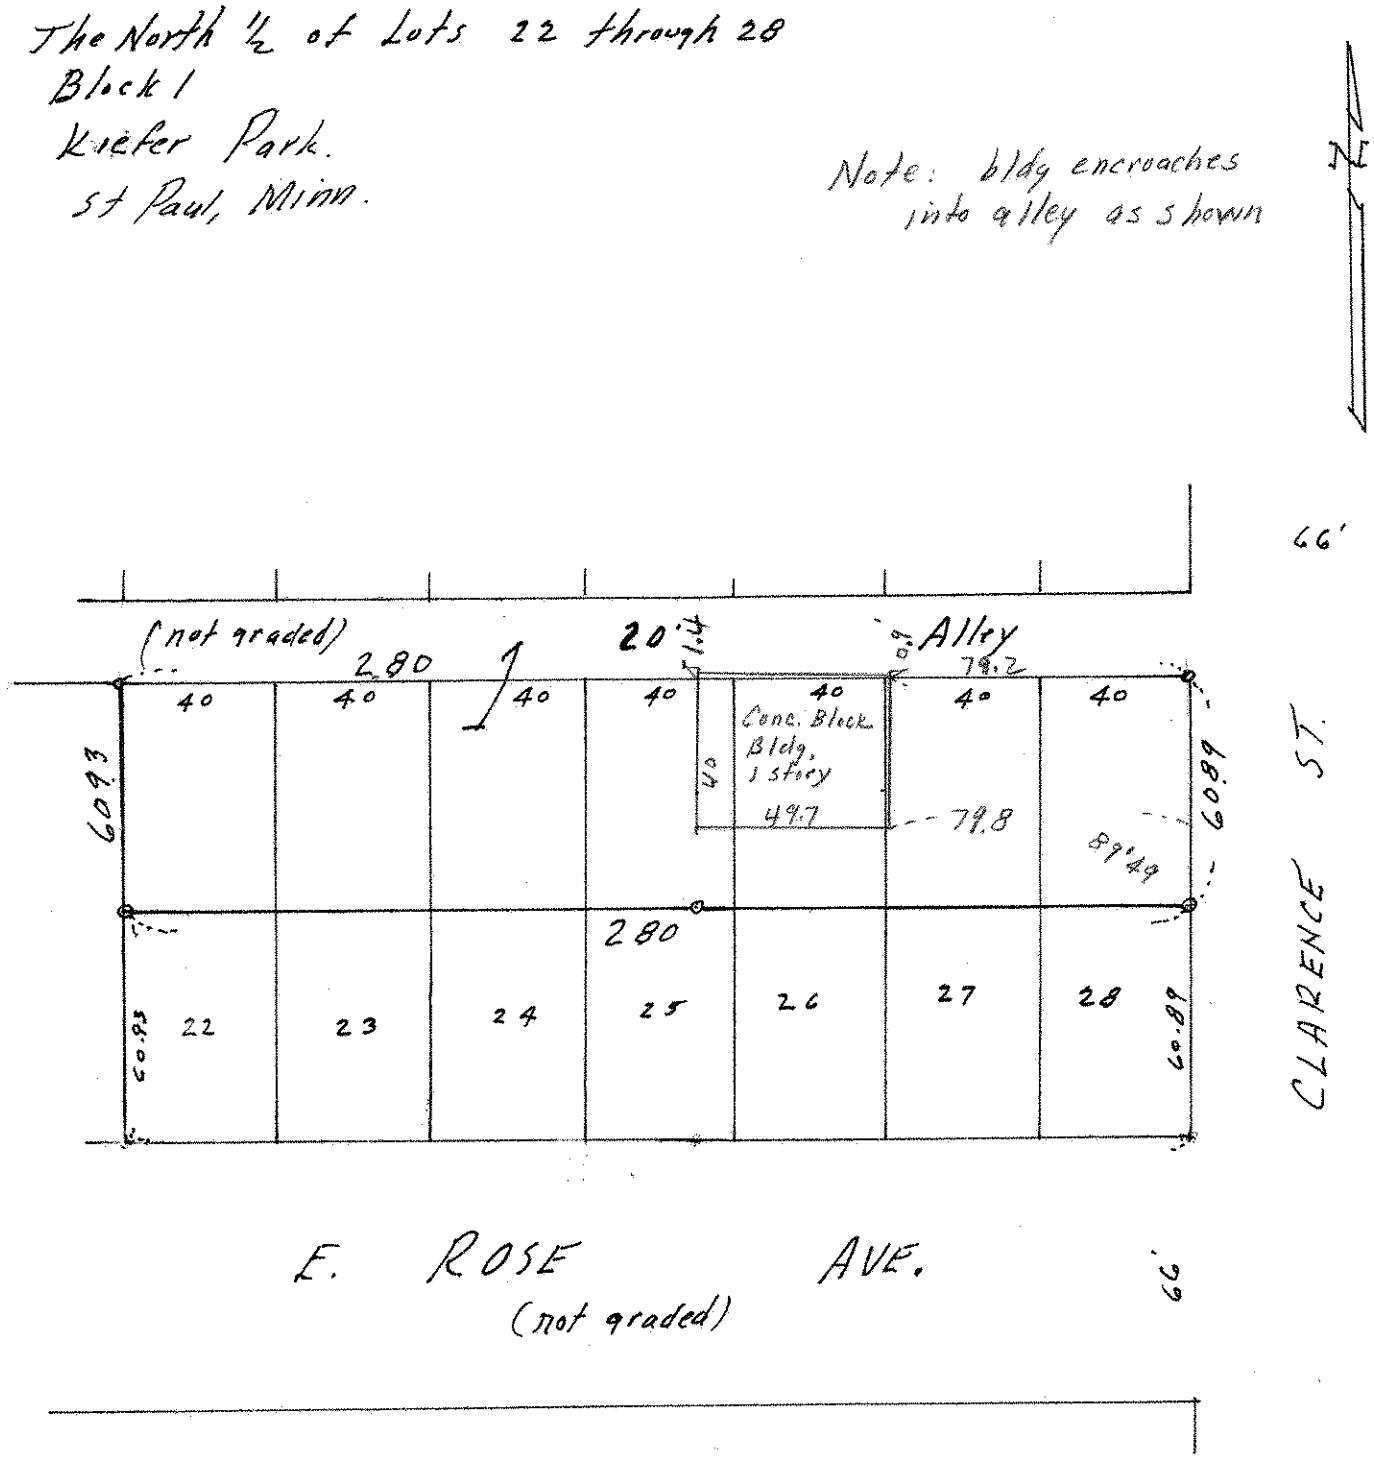
Note: bldg encroaches into alley as shown