

ROBERT A. BUSCH


Land Surveyor

REGISTERED UNDER LAWS OF STATE OF MINNESOTA

PHONE 724-6308

2821 30TH AVE. SO. MINNEAPOLIS, MINN. 55406

Surveyor's Certificate

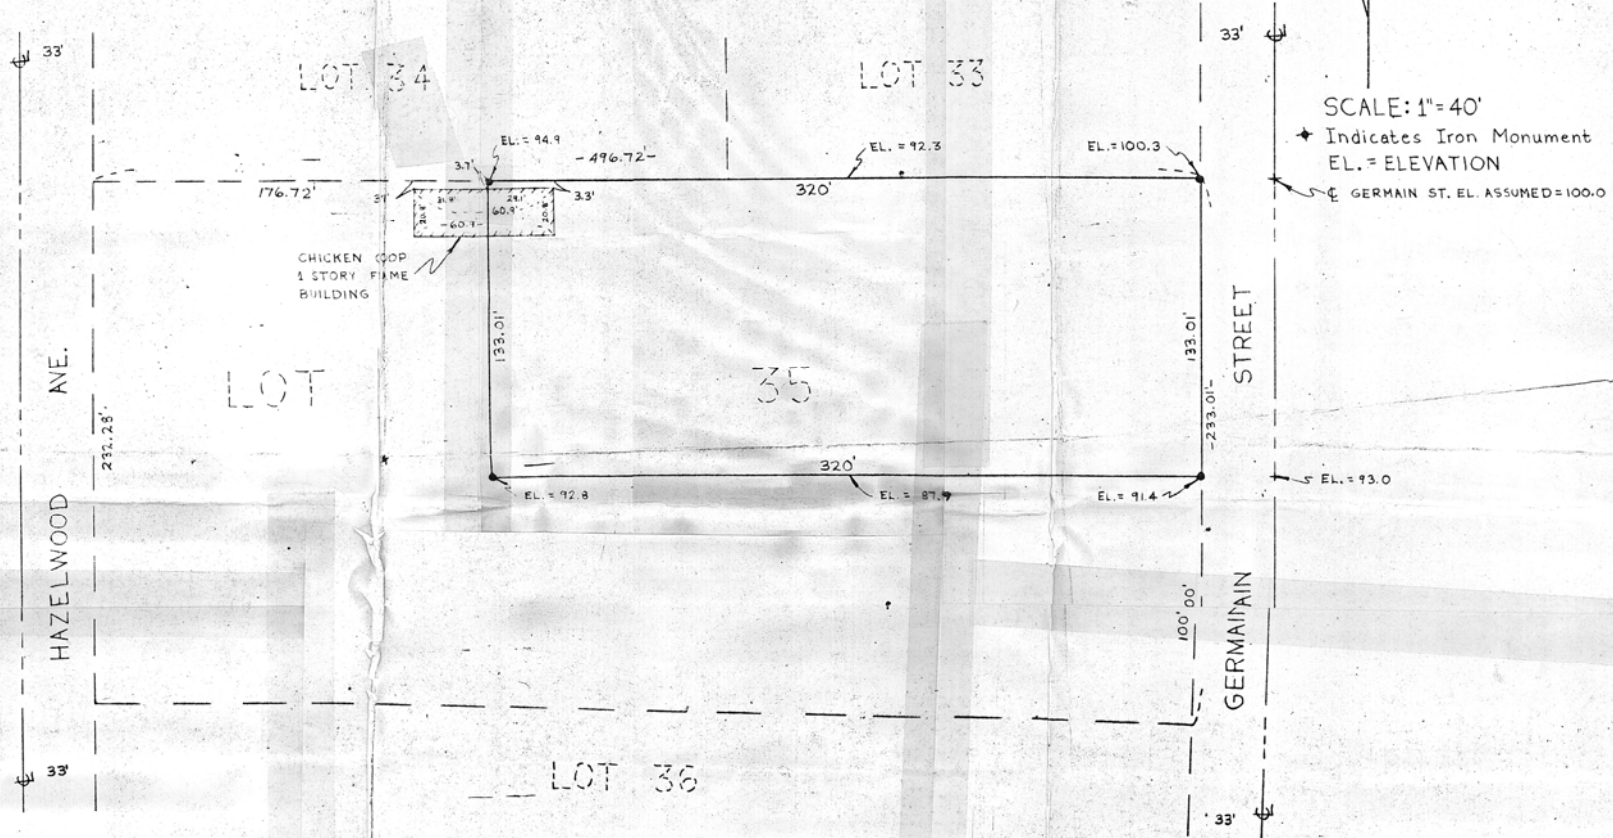

I HEREBY CERTIFY THAT THIS IS A TRUE AND CORRECT REPRESENTATION OF A SURVEY OF THE BOUNDARIES OF THE NORTH 133.01 FEET OF THE EAST 320 FEET OF LOT 35, BLOCK ONE, AMONGS SUBDIVISION NO. 78, RAMSEY COUNTY, MINNESOTA, AND OF THE LOCATION OF ALL BUILDINGS, IF ANY, THEREON, AND ALL VISIBLE ENCROACHMENTS, IF ANY, FROM OR ON SAID LAND.

AS SURVEYED BY ME THESE 4TH DAYS OF AUGUST, 1967 A.D.

SIGNED *Robert A. Busch*
MINNESOTA REGISTRATION NO. 7089

Doc Hansen
920-7147